

MICHIGAN
DEPARTMENT OF CONSERVATION
FORESTRY DIVISION

LAND CORNER RECORD

T. 28 N.R. 2 E


OSCODA COUNTY

DESCRIPTION OF CORNER 1/4 corner on S. side Sec. 32, T28N-R2E

CORNER MONUMENT Set DNR Monument

DATE MONUMENT PLACED AND WITNESSED 5-16-69

WITNESSES TO CORNER.....

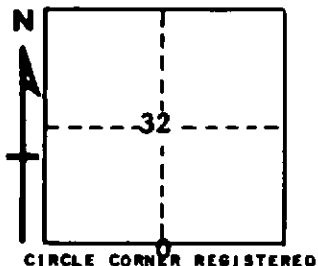

| | | |
|--------------------------------|---------------|--------------|
| <u>7" J. Pine</u> | <u>N 40 E</u> | <u>36.6'</u> |
| <u>5" R. Pine</u> | <u>N 35 W</u> | <u>41.9'</u> |
| <u>AND Old NBT 12" B. Oak</u> | <u>N 48 W</u> | <u>42.6'</u> |
| <u>Old NBT 10" J. Pine Stp</u> | <u>N 72 E</u> | <u>41.9'</u> |

DESCRIPTION IN DETAIL AS TO HOW CORNER WAS LOCATED AND IDENTIFIED OR RESTORED.

This corner was found during a retracement in this area. Found 1½" pipe at corner as perpetuated by Marcus Schaaf from record of earlier survey by Seeley. Considered properly located. Falls in centerline N-S road and fireline E & W.

SURVEYOR'S SEAL

SIGNED *Luath Pettig* DATE 6/9/69
REGISTERED LAND SURVEYOR 10068