

MICHIGAN  
DEPARTMENT OF CONSERVATION  
FORESTRY DIVISION

LAND CORNER RECORD

T. 28 N.R. 2 E


OSCODA COUNTY

DESCRIPTION OF CORNER Sec. corner common to sections 15-16-21-22

CORNER MONUMENT Set DNR Monument

DATE MONUMENT PLACED AND WITNESSED \_\_\_\_\_

WITNESSES TO CORNER..... \_\_\_\_\_

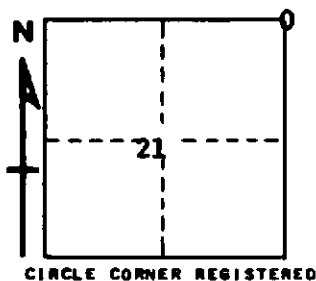

Remarked Caldwell NBTs

* 24" Oak	N 32 E	34.8'
12" Oak	S 52 W	74.8'
AND 10" Oak	N 59 W	92.1'
* Also C. O. Seeley NBT		

DESCRIPTION IN DETAIL AS TO HOW CORNER WAS LOCATED AND IDENTIFIED OR RESTORED.

This corner was found during a survey in this township. Found iron bolt near surface, but Seeley's pipe and wood stake about 2' below surface at corner. Seeley restored this corner after recovering good corners North and South. Road construction and other occupation and surveys based on this location, and appears most acceptable as proper location for corners.

Schaaf pipe removed.

SURVEYOR'S SEAL

SIGNED *Ernest Hitting* DATE 6-9-69  
REGISTERED LAND SURVEYOR 10068