


SI  
SECTION

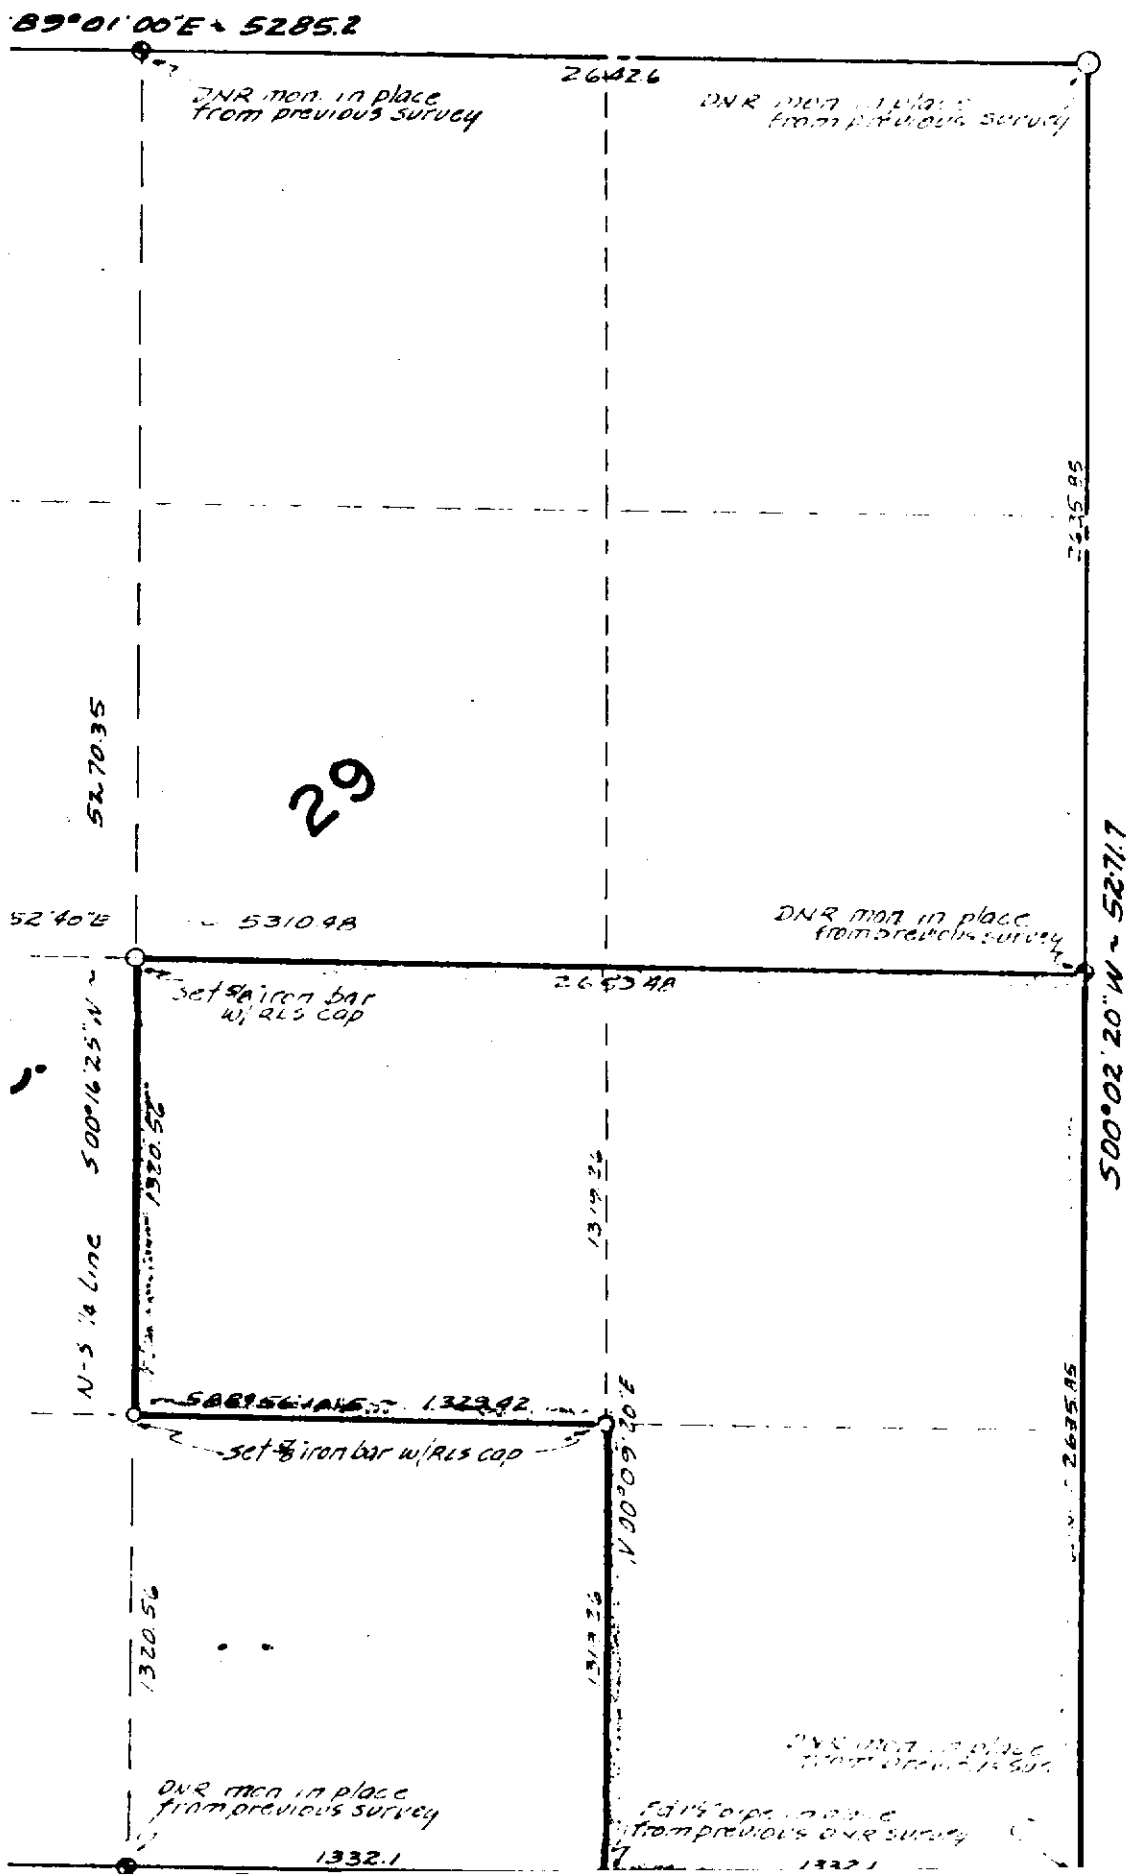

THROU

THE

PREVIOUS

SECTION

SECTION

SURVEY

SECTION

SECTION

SECTION

SECTION