

LAND CORNER RECORDATION CERTIFICATE

FILING REQUIREMENT OF ACT 74, MICH. P.A. 1970

FOR CORNERS OF --:	LOCATED IN --:	CORNER CODE NUMBER
1. PUBLIC LAND SURVEY	T. 28 N. R. 2 E.	D-10
2. PROPERTY CONTROLLING IN SECTION	29 T. 28 N. R. 2 E.	8; 12; 13
3. MISCELLANEOUS PROPERTY IN SECTION	T. N. R. E.	
4. LOT NO. _____, RECORDED PLAT _____		
5. PRIVATE CLAIMS _____		

REGISTER OF DEEDS STAMP AND FILING NUMBER

I, Kenneth J. Ostling, do hereby certify that under requirements of P.A. 74, Michigan P.A. of 1970, the corner points mentioned in lines 1 and 2 above were, in a field survey on January 21, 1980, established, re-established, monumented, re-monumented, recovered or restored as expressed below and in conformance with regulations and rules therefore as required in the current manual of survey instructions of the United States Department of the Interior, Bureau of Land Management or by a decree of a court of law. Furthermore, that the corner points mentioned in lines 3, 4 and 5 above were, in a field survey on _____, 19____, found, recovered, restored, established or re-established as expressed below and in conformance with the rules of the Michigan State Board of Registration for Land Surveyors or, by a Decree of a Court of law:

A. Description of original monument and accessories and or subsequent restoration:

B. Description of corner evidence found and/or method applied in restoring or re-establishing corner:


- D-10 Set at calculated true intersection of $\frac{1}{4}$ lines, according to standard survey procedure for the subdivision of sections.
- 8 Set by standard survey procedure for the subdivision of sections.
- 12 Set by standard survey procedure for the subdivision of sections.
- 13 Set by standard survey procedure for the subdivision of sections.

C. Description of monument for corner and accessories established to perpetuate locating the position of the corner:

D-10	8	12
Set 5/8 rod w/RLS cap red top post	Set 5/8 rod w/RLS Cap	Set 5/8rod w/RLS cap
7" J. Pine N51°E 6.5'	2" R. Pine S08°W 53.1'	Red. top post
8" J. Pine N16°W 15.4'	2" R. Pine S74°W 20.6'	4" J. Pine N03°W 9.0'
		6" J. Pine N56°E 9.1'
13		
Set 5/8 Rod w/RLS Cap, red top post		
6" J. Pine N85°E 11.5'		
8" J. Pine N09°W 17.4'		

SIGNED BY Kenneth J. Ostling
 SURVEYOR'S MICHIGAN REGISTRATION NO. _____

DATE 9/4/80

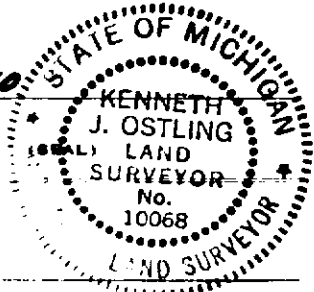

FOR STATE AND UNITED STATES AGENCIES:

SIGNED BY _____ DATE _____
CHIEF OF SURVEY PARTY
 APPROVED AND SIGNED BY _____ DATE _____
MICHIGAN REGISTERED LAND SURVEYOR

SURVEYOR'S MICHIGAN REGISTRATION NO. _____