

LAND CORNER RECORDATION CERTIFICATE

FILING REQUIREMENT OF ACT 74, MICH. P.A.1970

FOR CORNERS OF--:	LOCATED IN--:	CORNER CODE NUMBER
1. PUBLIC LAND SURVEY _____	T. <u>28</u> ^{N.} S. , R. <u>2</u> ^{E.} W.	<u>H-8</u> ;
2. PROPERTY CONTROLLING IN SECTION <u>22</u>	, T. <u>28</u> ^{N.} S. , R. <u>2</u> ^{E.} W.	<u>8; 11</u>
3. MISCELLANEOUS PROPERTY IN SECTION _____	, T. _____ ^{N.} S. , R. _____ ^{E.} W.	_____
4. LOT NO. _____, RECORDED PLAT _____		
5. PRIVATE CLAIMS _____		

REGISTER OF DEEDS STAMP AND FILING NUMBER

I, KENNETH J. OSTLING, do hereby certify that under requirements of P.A. 74, Michigan P.A. of 1970, the corner points mentioned in lines 1 and 2 above were, in a field survey on JUNE 15, 1983, established, re-established, monumented, re-monumented, recovered or restored as expressed below and in conformance with regulations and rules therefore as required in the current manual of survey instructions of the United States Department of the Interior, Bureau of Land Management or by a decree of a court of law. Furthermore, that the corner points mentioned in lines 3, 4 and 5 above were, in a field survey on _____, 19____, found, recovered, restored, established or re-established as expressed below and in conformance with the rules of the Michigan State Board of Registration for Land Surveyors or, by a Decree of a Court of law:

A. Description of original monument and accessories and/or subsequent restoration:

B. Description of corner evidence found and/or method applied in restoring or re-establishing corner:

- H-8 - SET AT CALCULATED INTERSECTION OF TRUE 1/4 LINES.
- 8 - SET BY STANDARD SURVEY PROCEDURE FOR THE SUBDIVISION OF SECTIONS.
- 11 - SET BY STANDARD SURVEY PROCEDURE FOR THE SUBDIVISION OF SECTIONS.


C. Description of monument for corner and accessories established to perpetuate locating the position of the corner:

<p style="text-align: center;"><u>H-8</u></p> <p>SET 5/8" BAR WITH CAP</p> <p>9" RED MAPLE N25°E 14.1'</p> <p>12" RED OAK S53°E 9.9'</p>	<p style="text-align: center;"><u>8</u></p> <p>SET 5/8" BAR WITH CAP</p> <p>4" RED PINE N16°W 57.8'</p> <p>6" RED PINE N16°E 88.6'</p>
--	--

<p style="text-align: center;"><u>11</u></p> <p>SET 5/8" BAR WITH RLS CAP</p> <p>14" WHITE PINE N45°W 48.0'</p> <p>10" WHITE PINE S15°W 45.3'</p>

SIGNED BY *Kenneth J. Ostling* DATE _____

SURVEYOR'S MICHIGAN REGISTRATION NO. 10068

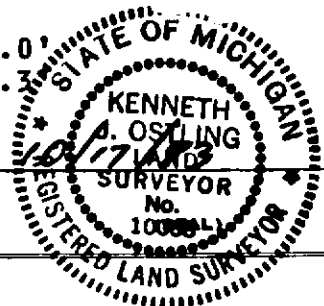

FOR STATE AND UNITED STATES AGENCIES:

SIGNED BY _____ DATE _____

CHIEF OF SURVEY PARTY

APPROVED AND SIGNED BY _____ DATE _____

MICHIGAN REGISTERED LAND SURVEYOR (SEAL)

SURVEYOR'S MICHIGAN REGISTRATION NO. _____ OSCODA COUNTY