


Filing Requirement of Act 74, Mich. PA 1970

For Corners In:
Oscoda
 (County)

	Located In	Corner Code #
1. Public Land Survey	T <u>28N</u> R <u>2E</u>	<u>E-3</u>
	T <u>28N</u> R <u>2E</u>	<u>F-3</u>
2. Property Controlling in Section	S _____ T _____ R _____	_____
	S _____ T _____ R _____	_____
3. Miscellaneous Property in Section	S _____ T _____ R _____	_____
	S _____ T _____ R _____	_____
4. Lot No: _____	Recorded Plat: _____	
5. Private Claims: _____		

Register of Deeds Stamp & File Number

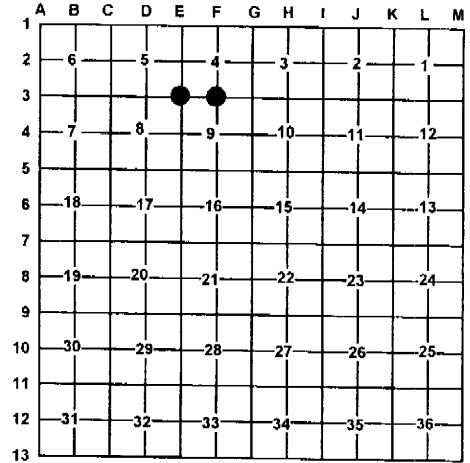

I, Carl T. Kiiskila, in a field survey on December 3, 2004 do hereby state that under requirements of PA 74, Michigan PA of 1970, the corner points mentioned in lines 1 and 2 above were in conformance with regulations and rules therefore as required in the current manual of survey instructions of the United States Department of the Interior, Bureau of Land Management or by a decree of a Court of Law and/or that the corner points mentioned in lines 3, 4 and 5 above were in conformance with the rules of the Michigan Board of Land Surveyors or by a Decree of a Court of Law; established, re-established, monumented, recovered, found as expressed below:

NOTE: Not more than 2 corners, all in the same town and range, may be recorded on this certificate.

A. Description of original monument and accessories and/or subsequent restoration:

E-3 G.L.O. William Coon 1839 set post corner section 8,9,4, and 5 Wit: Spruce Pine 9 N38°E 5 links
 Spruce Pine 4 S32.5°W 12.5 links

F-3 G.L.O. William Coon 1839 set quarter section post
 Wit: No trees convenient for bearing.

December 1970, Kenneth J. Ostling R.L.S. #10068 reestablished this corner by proportionate measurement.

Wit: 6" J. Pine S70°E 4.0'
 7" J. Pine N14°E 8.4'

December 1970, Kenneth J. Ostling R.L.S. #10068 reestablished the North quarter corner of section 9 midpoint and on line between section corners.

Wit: 6" Oak West 5.0'
 6" Oak N16°E 13.7'

B. Description of corner evidence found and/or method applies in restoring or re-establishing corner:

E-3 Found 1" pipe with broken DNR cap as set by Kenneth J. Ostling.

F-3 Reestablished the North quarter corner of section 9 midway on line between Northwest corner and Northeast corner of section 9. (No evidence of K.J. Ostling corner or witnesses found.)

C. Description of monument for corner and accessories established to perpetuate locating the position of the corner:

E-3 1" pipe with broken DNR cap
 Wit: 3" J. Pine S61°E 66.08'
 3" J. Pine N10°W 31.76'
 3" J. Pine N72°W 16.83'
 3" J. Pine S44°W 34.65'
 Blue Carsonite Post North 1'±
 East-West two track South 6'±

F-3 Set 1" X 32" pipe with DNR cap
 Wit: 6" Oak S16°E 101.54'
 11" Oak S12°W 76.05'
 13" Oak S63°W 85.10'
 Blue Carsonite Post North .95'
 North two track West 15'±

Signed by: Carl T. Kiiskila
 Surveyor's Michigan License No.: 33981

Date: 1-6-05

