


LAND CORNER RECORDATION CERTIFICATE

Filing Requirement of Act 74, Mich. PA 1970

For Corners In:			
Oscoda	Located In	Corner Code #	
(County)			
1. Public Land Survey	T <u>28N</u>	R <u>2E</u>	<u>F-4</u>
	T <u>28N</u>	R <u>2E</u>	<u>F-5</u>
2. Property Controlling in Section	S _____	T _____	R _____
	S _____	T _____	R _____
3. Miscellaneous Property in Section	S _____	T _____	R _____
	S _____	T _____	R _____
4. Lot No: _____	Recorded Plat: _____		
5. Private Claims: _____			

Register of Deeds Stamp & File Number

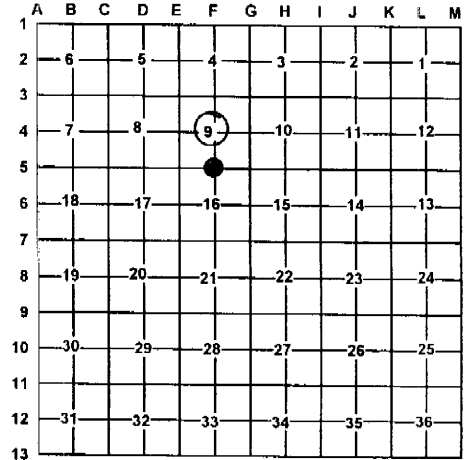

I, Carl T. Kiiskila, in a field survey on December 3, 2004 do hereby state that under requirements of PA 74, Michigan PA of 1970, the corner points mentioned in lines 1 and 2 above were in conformance with regulations and rules therefore as required in the current manual of survey instructions of the United States Department of the Interior, Bureau of Land Management or by a decree of a Court of Law and/or that the corner points mentioned in lines 3, 4 and 5 above were in conformance with the rules of the Michigan Board of Land Surveyors or by a Decree of a Court of Law; established, re-established, monumented, recovered, found as expressed below:

NOTE: Not more than 2 corners, all in the same town and range, may be recorded on this certificate.

A. Description of original monument and accessories and/or subsequent restoration:

F-4 This corner position was not established during the original government survey.

F-5 G.L.O. William Coon 1839 set quarter section post
Wit: Spruce Pine 9 N38°E 5 links
Spruce Pine 4 S32.5°E 12.5 links

Liber 2, Page 252 November 1969 Kenneth J. Ostling R.L.S. #10068 found G.D. Henning's post bottom set Department Monument.

Wit: 4" R. Pine N06°W 33.6'
8" J. Pine N82°E 24.5'

B. Description of corner evidence found and/or method applies in restoring or re-establishing corner:

F-4 Established the center of section 9 at the intersections of North-South and East-West quarter lines.

F-5 Found DNR monument as set by Kenneth J. Ostling.

C. Description of monument for corner and accessories established to perpetuate locating the position of the corner:

F-4 Set 5/8" X 32" rod with P.S. cap #33981

Wit: 14" R. Pine	N36°E	42.18'
5" Maple	S22°E	7.27'
8" R. Pine	S79°W	34.47'
6" Maple	N34°W	12.39'
Blue Carsonite Post	North	1±

F-5 DNR monument

Wit: 7" W. Pine	S57°W	44.61'
P. Pole	N68°W	28.66'
12" R. Pine	N21°E	33.83'
14" J. Pine	S34°E	62.97'

Signed by: Carl T Kiiskila
Surveyor's Michigan License No.: 33981

Date: 1-6-05

