

# LAND CORNER RECORDATION CERTIFICATE

## FILING REQUIREMENT OF ACT 74, MICH. P.A.1970

FOR CORNERS OF--:	LOCATED IN--:	CORNER CODE NUMBER
1. PUBLIC LAND SURVEY _____	T. <u>28</u> N. <input checked="" type="radio"/> R. <u>3</u> E. <input checked="" type="radio"/>	<u>D-4</u>
2. PROPERTY CONTROLLING IN SECTION <u>8</u>	, T. <u>28</u> N. <input checked="" type="radio"/> R. <u>3</u> E. <input checked="" type="radio"/>	<u>8; 12</u>
3. MISCELLANEOUS PROPERTY IN SECTION _____	, T. _____ N. <input type="radio"/> S. <input type="radio"/> R. _____ E. <input type="radio"/> W. <input type="radio"/>	_____
4. LOT NO. _____, RECORDED PLAT _____		
5. PRIVATE CLAIMS _____		

REGISTER OF DEEDS STAMP AND FILING NUMBER

I, Kenneth J. Ostling, do hereby certify that under requirements of P.A. 74, Michigan P.A. of 1970, the corner points mentioned in lines 1 and 2 above were, in a field survey on August 20, 1975, established, re-established, monumented, re-monumented, recovered or restored as expressed below and in conformance with regulations and rules therefore as required in the current manual of survey instructions of the United States Department of the Interior, Bureau of Land Management or by a decree of a court of law. Furthermore, that the corner points mentioned in lines 3, 4 and 5 above were, in a field survey on \_\_\_\_\_, 19\_\_\_\_, found, recovered, restored, established or re-established as expressed below and in conformance with the rules of the Michigan State Board of Registration for Land Surveyors or, by a Decree of a Court of law:

A. Description of original monument and accessories and/or subsequent restoration:


B. Description of corner evidence found and/or method applied in restoring or re-establishing corner:

- D-4 Set at intersection of true  $\frac{1}{4}$  lines.
- 8 Set by standard survey procedure for the subdivision of sections.
- 12 Set by standard survey procedure for the subdivision of sections.

C. Description of monument for corner and accessories established to perpetuate locating the position of the corner:

D-4	8	12
Set 1½" pipe & red-top post	Set 1½" pipe & red-top post	Set 1½" pipe & red-top post
12" R. Pine N41°E 35.8	3" R. Pine S71°W 61.2	11" J. Pine S41°W 32.0
5" R. Pine N02°E 82.5	2" R. Pine N42°W 80.6	14" J. Pine N31°W 18.1

SIGNED BY: *Kenneth J. Ostling*

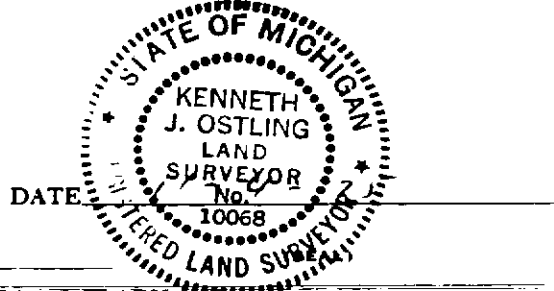

SURVEYOR'S MICHIGAN REGISTRATION NO. 10068

FOR STATE AND UNITED STATES AGENCIES:

SIGNED BY \_\_\_\_\_ DATE \_\_\_\_\_  
CHIEF OF SURVEY PARTY

APPROVED AND SIGNED BY \_\_\_\_\_ DATE \_\_\_\_\_  
MICHIGAN REGISTERED LAND SURVEYOR

(SEAL)

SURVEYOR'S MICHIGAN REGISTRATION NO. \_\_\_\_\_