

STATE OF MICHIGAN
DEPARTMENT
OF
NATURAL RESOURCES

LAND CORNER RECORD


OSCODA COUNTY
T 28 N R 3 E

DESCRIPTION OF CORNER N 1/4, Section 29

CORNER MONUMENT Set DNR Monument

DATE MONUMENT PLACED AND WITNESSED 5-18-72

WITNESSES TO CORNER.....

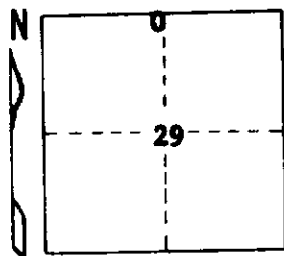

5" Maple N 40 W 24.2'


5" Maple S 06 W 14.8'

AND

CIRCLE CORNER REGISTERED

DESCRIPTION IN DETAIL AS TO HOW CORNER WAS LOCATED AND IDENTIFIED OR RESTORED.

This corner set by proportionate measurement between section corners. Nothing for evidence of a previous corner in this vicinity.

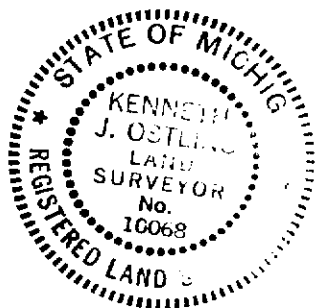

SURVEYOR'S SEAL

SIGNED Kenneth J. Ostling DATE 5-24-72
REGISTERED LAND SURVEYOR
10068

DISTRIBUTION:

County Courthouse
Area Forester (Regions I & II)
District or Region Surveyor
Forestry Div., Lansing

R 4047
Rev. 10/68