


STATE OF MICHIGAN
DEPARTMENT
OF
NATURAL RESOURCES

LAND CORNER RECORD

OSCODA COUNTY
T 28 N R 3 E

DESCRIPTION OF CORNER E 1/4 - Sec. 32
CORNER MONUMENT Set DNR Monument
DATE MONUMENT PLACED AND WITNESSED 5-18-72
WITNESSES TO CORNER..... 4" W. Pine S 44 E 26.0'

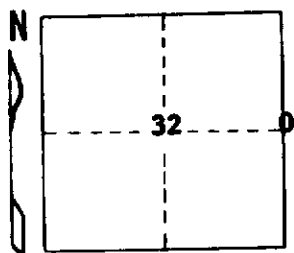


5" W. Pine N 43 E 61.5'
* 40" W. Pine Stp N 02 W 18.1'
AND
* C. O. Seeley NBT

CIRCLE CORNER REGISTERED

DESCRIPTION IN DETAIL AS TO HOW CORNER WAS LOCATED AND IDENTIFIED OR RESTORED.

Found Seeley post at fence corner, as established in early County survey.

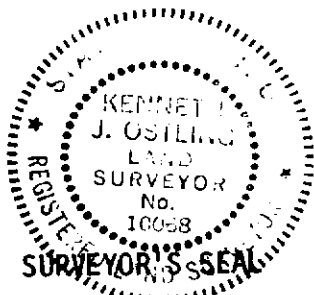

SIGNED Kenneth J. Ostling DATE 5-24-72
REGISTERED LAND SURVEYOR
10068

DISTRIBUTION:

County Courthouse
Area Forester (Regions I & II)
District or Region Surveyor
Forestry Div., Lansing

R 4047
Rev. 10/68