


STATE OF MICHIGAN
DEPARTMENT
OF
NATURAL RESOURCES

LAND CORNER RECORD

OSCODA COUNTY
T 28 N R 3 E

DESCRIPTION OF CORNER NE Corner Section 32
CORNER MONUMENT Set DNR Monument
DATE MONUMENT PLACED AND WITNESSED 5-18-72
WITNESSES TO CORNER..... 4" W. Pine N 01 W 29.7'

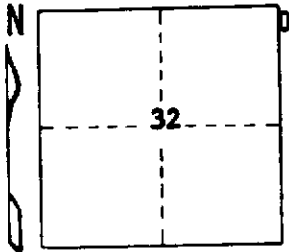


* 30" W. Pine Stp N 64 W 36.0'
36" W. Pine stub S 17 E 29.3'
AND * Seeley NBT

CIRCLE CORNER REGISTERED

DESCRIPTION IN DETAIL AS TO HOW CORNER WAS LOCATED AND IDENTIFIED OR RESTORED.

Found corner as established by County Surveyor Seeley in early 1900s. Best evidence of proper location.

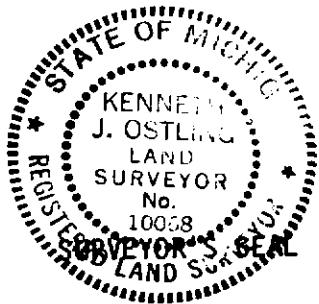

DISTRIBUTION:

County Courthouse
Area Forester (Regions I & II)
District or Region Surveyor
Forestry Div., Lansing

SIGNED Kenneth J. Ostling DATE 5-24-72
REGISTERED LAND SURVEYOR 10058

R 4047
Rev. 10/68