

STATE OF MICHIGAN  
DEPARTMENT  
OF  
NATURAL RESOURCES

LAND CORNER RECORD


OSCODA COUNTY  
T 28 N R 3 E

DESCRIPTION OF CORNER S 1/4, Section 29

CORNER MONUMENT Set DNR Monument

DATE MONUMENT PLACED AND WITNESSED 5-18-72

WITNESSES TO CORNER.....

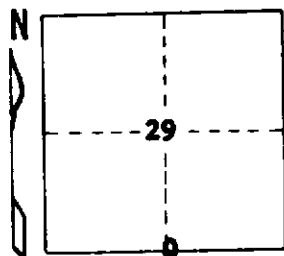

40" W. Pine Stp. S 43 E 96.8'


20" R. Pine N 64 E 107.5'

AND

CIRCLE CORNER REGISTERED

DESCRIPTION IN DETAIL AS TO HOW CORNER WAS LOCATED AND IDENTIFIED OR RESTORED.

Corner set by proportionate measurement between section corners. Falls in pasture about 90' West of N-S fence line. No evidence of any previous corner.

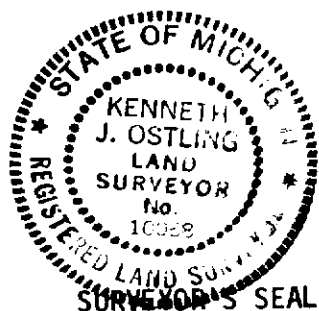

SIGNED Kenneth J. Ostling DATE 5-24-72  
REGISTERED LAND SURVEYOR 10068

DISTRIBUTION:

County Courthouse  
Area Forester (Regions I & II)  
District or Region Surveyor  
Forestry Div., Lansing

R 4047  
Rev. 10/68