


STATE OF MICHIGAN
DEPARTMENT
OF
NATURAL RESOURCES
LAND CORNER RECORD

OSCODA COUNTY
T 28 N R 3 E

DESCRIPTION OF CORNER NW Corner, Section 29
CORNER MONUMENT Set DNR Monument
DATE MONUMENT PLACED AND WITNESSED 5-18-72
WITNESSES TO CORNER.....

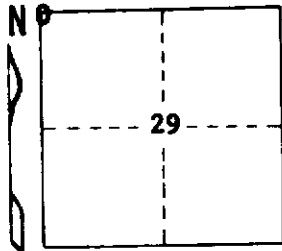


16" R. Pine S 42 E 49.0'
20" R. Pine N 32 E 26.6'
AND

CIRCLE CORNER REGISTERED

DESCRIPTION IN DETAIL AS TO HOW CORNER WAS LOCATED AND IDENTIFIED OR RESTORED.

Set this corner by proportionate measurement between corners 1 mile East and 1 mile West, in the apparent centerline of the E-W County Road. Feel this method produces the most equitable distribution of the available lands. Fence lines in this area conform to no acceptable pattern of survey, and no previous monument could be located.

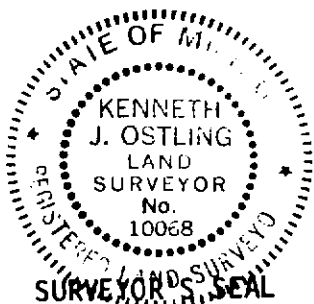

SIGNED Kenneth J. Ostling DATE 5-24-72
REGISTERED LAND SURVEYOR 10068

DISTRIBUTION:

County Courthouse
Area Forester (Regions I & II)
District or Region Surveyor
Forestry Div., Lansing

R 4047
Rev. 10/68