


STATE OF MICHIGAN  
DEPARTMENT  
OF  
NATURAL RESOURCES

LAND CORNER RECORD

OSCODA COUNTY  
T 28 N R 3 E

DESCRIPTION OF CORNER N 1/4 - Sec. 30  
CORNER MONUMENT Set DNR Monument below surface  
DATE MONUMENT PLACED AND WITNESSED 5-18-72  
WITNESSES TO CORNER.....

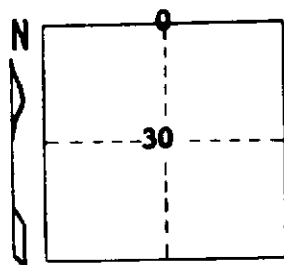


12" Oak S 15 E 35.5'  
22" Oak N 5 E 7.85'  
AND

CIRCLE CORNER REGISTERED

DESCRIPTION IN DETAIL AS TO HOW CORNER WAS LOCATED AND IDENTIFIED OR RESTORED.

This corner set by proportionate measurement between section corners. Corner falls 110' West of fence line North and 1 wire fence line South, but can not accept that fences in this area are based on proper survey procedures. No indication of a previous corner monument.

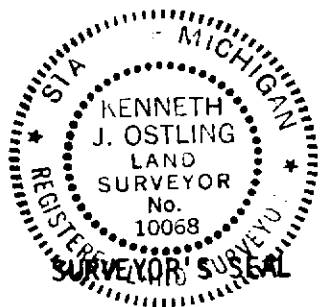

SIGNED Kenneth J. Ostling DATE 5-24-72  
REGISTERED LAND SURVEYOR 10068

DISTRIBUTION:

County Courthouse  
Area Forester (Regions I & II)  
District or Region Surveyor  
Forestry Div., Lansing

R 4047  
Rev. 10/68