

STATE OF MICHIGAN
DEPARTMENT
OF
NATURAL RESOURCES

LAND CORNER RECORD


OSCODA COUNTY
T 28 N R 3 E

DESCRIPTION OF CORNER W 1/4 Corner

CORNER MONUMENT Set Dept. Monument

DATE MONUMENT PLACED AND WITNESSED 5-19-72

WITNESSES TO CORNER.....

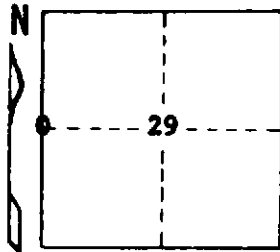

12" R. Pine S 74 W 41.6'


19" W. Pine N 15 W 17.3'

AND

CIRCLE CORNER REGISTERED

DESCRIPTION IN DETAIL AS TO HOW CORNER WAS LOCATED AND IDENTIFIED OR RESTORED.

Corner set by proportionate measurement between section corners. No evidence of a previous corner.

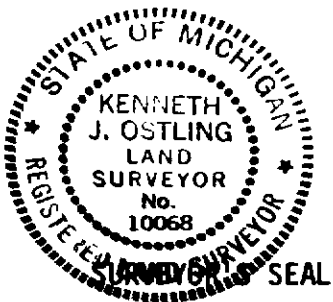

SIGNED

Kenneth J. Ostling
REGISTERED LAND SURVEYOR
10068

DATE

5-26-72

DISTRIBUTION:

Forestry Division, Lansing