

STATE OF MICHIGAN
DEPARTMENT
OF
NATURAL RESOURCES
LAND CORNER RECORD


OSCODA COUNTY
T 28 N R 3 E

DESCRIPTION OF CORNER S 1/16 corner on E. Section line

CORNER MONUMENT Set 2' of 1" pipe

DATE MONUMENT PLACED AND WITNESSED 5-18-72

WITNESSES TO CORNER.....

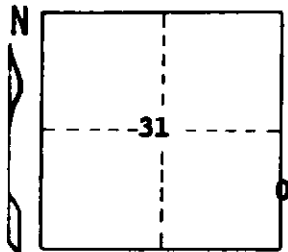

6" W. Pine S 35 E 53.15'


10" W. Pine S 70 E 57.9'

AND

CIRCLE CORNER REGISTERED

DESCRIPTION IN DETAIL AS TO HOW CORNER WAS LOCATED AND IDENTIFIED OR RESTORED.

Corner set by standard procedure for the subdivision of sections.

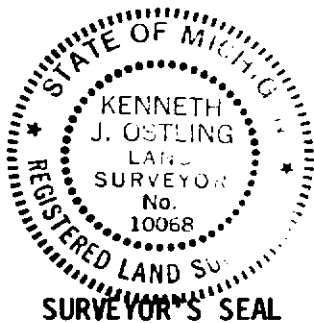

SIGNED Kenneth J. Ostling DATE 5-25-72
REGISTERED LAND SURVEYOR 10068

DISTRIBUTION:

Forestry Division, Lansing