

STATE OF MICHIGAN  
DEPARTMENT  
OF  
NATURAL RESOURCES

LAND CORNER RECORD


OSCODA COUNTY  
T 28 N R 3 E

DESCRIPTION OF CORNER N.E. Corner Sec. 29

CORNER MONUMENT Set Dept. Monument

DATE MONUMENT PLACED AND WITNESSED 5-18-72

WITNESSES TO CORNER.....

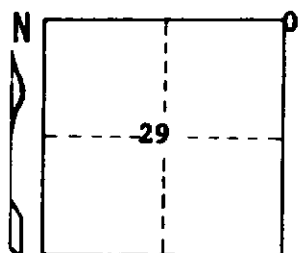

6" Maple S 70 E 17.2'


11" Maple S 24 W 7.6'

AND

CIRCLE CORNER REGISTERED

DESCRIPTION IN DETAIL AS TO HOW CORNER WAS LOCATED AND IDENTIFIED OR RESTORED.

Believe this point is position established in 1900 survey by County Surveyor Albertson in a survey of Sections 21 and 22. Found part of brick at fence corner, in line with road East, and conforming to a proper split of fence occupation East and North. It would appear the fence North is on the section line, and the road constructed West of the line. Alignment and measurements in all directions support this position.

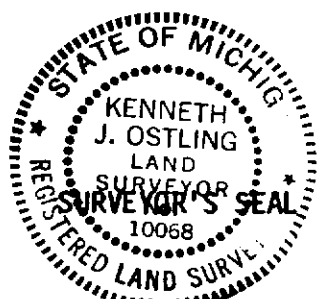

DISTRIBUTION:

Forestry Division, Lansing

SIGNED

*Kenneth J. Ostling*  
REGISTERED LAND SURVEYOR 10068

DATE

5-18-72