

STATE OF MICHIGAN
DEPARTMENT
OF
NATURAL RESOURCES

LAND CORNER RECORD


OSCODA COUNTY
T 28 N R 3 E

DESCRIPTION OF CORNER West 1/4 corner

CORNER MONUMENT Set DNR Mon. ~~XX~~

DATE MONUMENT PLACED AND WITNESSED 8-11-72

WITNESSES TO CORNER..... 11" Maple S 85 W 34.5'

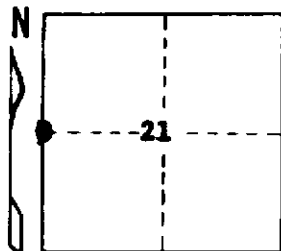

9" stem of Tw. Maple S 55 W 52.4'

Face of P.P. N 20 E 18.9'


AND

Old Fence in Line WEST

CIRCLE CORNER REGISTERED

DESCRIPTION IN DETAIL AS TO HOW CORNER WAS LOCATED AND IDENTIFIED OR RESTORED.

Found old brick, set by Albertson, beside old corner fence post. Set DNR Mon. and placed brick beside it.

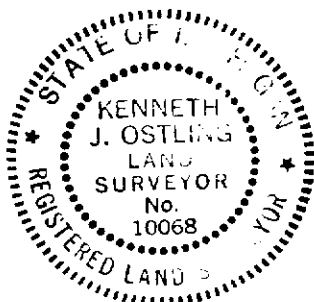

SURVEYOR'S SEAL

SIGNED Kenneth Ostling DATE 9-12-72
REGISTERED LAND SURVEYOR
10068

DISTRIBUTION:

Forestry Division, Lansing