

STATE OF MICHIGAN
DEPARTMENT
OF
NATURAL RESOURCES

LAND CORNER RECORD


OSCODA COUNTY
T 28 N R 3 E

DESCRIPTION OF CORNER NW Section Corner

CORNER MONUMENT Set DNR Monument

DATE MONUMENT PLACED AND WITNESSED 8-11-72

WITNESSES TO CORNER..... 19" Tw. Maple S 10 E 71.1'

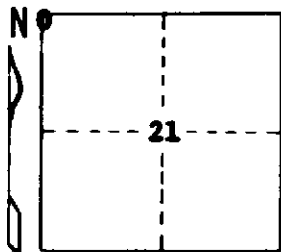

12" Soft Maple S 58 E 72.8'

Corner fence post South 25.5'

AND


Corner fence post S 69 W 65.2'

CIRCLE CORNER REGISTERED

DESCRIPTION IN DETAIL AS TO HOW CORNER WAS LOCATED AND IDENTIFIED OR RESTORED.

Double the distance and on line with the 1/4 corner & Section corner South, which falls 25' North of fence corner and in centerline of E-W Road (in line with fence on East side of N-S Road)

Fits Seeley record measurement.

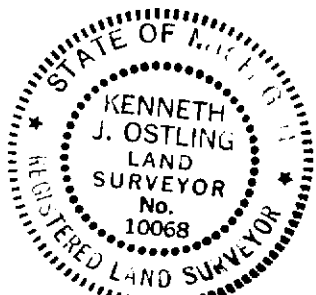

SURVEYOR'S SEAL

SIGNED

Kenneth J. Ostling
REGISTERED LAND SURVEYOR
10068

DATE

8-18-72

DISTRIBUTION:

Forestry Division, Lansing