

*van using
Escada Co.*

✓

LAND CORNER RECORDATION CERTIFICATE

FILING REQUIREMENT OF ACT 74, MICH. P.A.1970

FOR CORNERS OF--	LOCATED IN--	CORNER CODE NUMBER	
		B-1	C-1
1. PUBLIC LAND SURVEY _____	T. <u>28</u> N. S., R. <u>3</u> E. W.	B-5	C-5
2. PROPERTY CONTROLLING IN SECTION _____	T. _____ N. S., R. _____ E. W.		
3. MISCELLANEOUS PROPERTY IN SECTION _____	T. _____ N. S., R. _____ E. W.		
4. LOT NO. _____, RECORDED PLAT _____			
5. PRIVATE CLAIMS _____			

REGISTER OF DEEDS STAMP AND FILING NUMBER

I, Kenneth J. Ostling do hereby certify that under requirements of P.A. 74, Michigan P.A. of 1970, the corner points mentioned in lines 1 and 2 above (identified with circles on index code diagram - over) were, in a field survey on 11-10 1972, established, re-established, monumented, re-monumented, recovered or restored as expressed below and in conformance with regulations and rules therefore as required in the current manual of survey instructions of the United States Department of the Interior, Bureau of Land Management or by a decree of a court of law. Furthermore, that the corner points mentioned in lines 3, 4 and 5 above were, in a field survey on _____ 19____, found, recovered, restored, established or re-established as expressed below and in conformance with the rules of the Michigan State Board of Registration for Land Surveyors or, by a Decree of a Court of law:

A. Description of original monument and accessories and/or subsequent restoration:

B. Description of corner evidence found and/or method applied in restoring or re-establishing corner:


- B-1 Set corner by proportionate measurement between section corners.
- B-5 Set corner by proportionate measurement between section corners.
- C-1 Set corner at record measurement from standard corner 31-32, T29-3E. Stump in place for possible USBT.
- C-5 Set corner by proportionate measure for departure, and at latitude of average road line East and West.

C. Description of monument for corner and accessories established to perpetuate locating the position of the corner:

B-1	B-5	C-1
Set DNR Mon.	Set DNR Monument	Set DNR Monument
5" R. Pine S68E 91.7'	16" Tw Beech N30W 27.2'	5" R. Oak S08W 43.2'
4" R. Pine S15E 86.9'	4" H. Maple S10W 20.3'	8" R. Oak S66W 30.1'
Sec. 31 1/4 cor West 7.9'		R.P. Stub S55W 10.0'
		Cor. 31-32 West 7.9'

C-5
Set DNR Monument
12" H. Maple S55W 15.0
8" H. Maple N22E 21.3

SIGNED BY Kenneth J. Ostling DATE _____
SURVEYOR'S MICHIGAN REGISTRATION NO. 10068

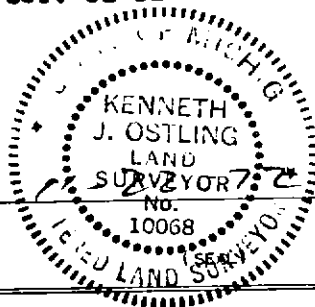

FOR STATE AND UNITED STATES AGENCIES:

SIGNED BY _____ DATE _____
CHIEF OF SURVEY PARTY

APPROVED AND SIGNED BY _____ DATE _____
MICHIGAN REGISTERED LAND SURVEYOR (SEAL)

SURVEYOR'S MICHIGAN REGISTRATION NO. _____