

Oscoda ✓

FOR CORNERS OF--	LOCATED IN--	CORNER CODE NUMBER
1. PUBLIC LAND SURVEY	T. 28 N. R. 3 E.	C-3, E-5
2. PROPERTY CONTROLLING IN SECTION	8, T. 28 N. R. 3 E.	Code 1
3. MISCELLANEOUS PROPERTY IN SECTION	, T. N. S., R. E. W.	
4. LOT NO.	, RECORDED PLAT	
5. PRIVATE CLAIMS		

REGISTER OF DEEDS STAMP AND FILING NUMBER

I, Kenneth J. Ostling do hereby certify that under requirements of P.A. 74, Michigan P.A. of 1970, the corner points mentioned in lines 1 and 2 above (identified with circles on index code diagram - over) were, in a field survey on 11-30 1972, established, re-established, monumented, re-monumented, recovered or restored as expressed below and in conformance with regulations and rules therefore as required in the current manual of survey instructions of the United States Department of the Interior, Bureau of Land Management or by a decree of a court of law. Furthermore, that the corner points mentioned in lines 3, 4 and 5 above were, in a field survey on \_\_\_\_\_ 19\_\_\_\_, found, recovered, restored, established or re-established as expressed below and in conformance with the rules of the Michigan State Board of Registration for Land Surveyors or, by a Decree of a Court of law:

A. Description of original monument and accessories and/or subsequent restoration:

B. Description of corner evidence found and/or method applied in restoring or re-establishing corner:


- C-3** Set corner by double proportionate measurement between corners 1 mile each direction. Nothing for a previous corner.
- E-5** Set this corner in line with average centerline of trail roads from West and North, at a point faced by a very old J.Pine NBT. Can find no record of this witness, but believe it to be by Frank Smith survey. Appears to be best available evidence of proper position for corner.
- Code 1** Set corner by standard survey procedure for the subdivision of sections.

C. Description of monument for corner and accessories established to perpetuate locating the position of the corner:

C-3		E-5		Code 1	
Set DNR MOn & Cedar post		Set DNR Monument		Set 1"x30" Pipe & Cedar Post	
5" R. Pine	N70E 109.5'	6" Maple	N31W 63.1'	6" R. Pine	N83W 30.2'
24" R. Pine	S05W 140.8'	5" R. Pine	S58W 24.9'	5" R. Pine	N25W 36.35'

SIGNED BY Kenneth J. Ostling DATE \_\_\_\_\_

SURVEYOR'S MICHIGAN REGISTRATION NO. 10068

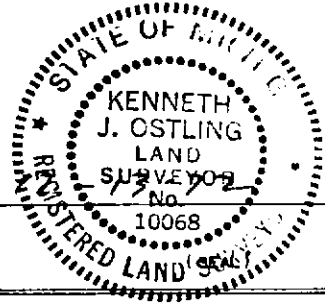

FOR STATE AND UNITED STATES AGENCIES:

SIGNED BY \_\_\_\_\_ DATE \_\_\_\_\_  
CHIEF OF SURVEY PARTY

APPROVED AND SIGNED BY \_\_\_\_\_ DATE \_\_\_\_\_  
MICHIGAN REGISTERED LAND SURVEYOR

(SEAL)

SURVEYOR'S MICHIGAN REGISTRATION NO. \_\_\_\_\_