

Oscoda Co. ✓

LAND CORNER RECORDATION CERTIFICATE

FILING REQUIREMENT OF ACT 74, MICH. P.A.1970

FOR CORNERS OF--:	LOCATED IN--:	CORNER CODE NUMBER
1. PUBLIC LAND SURVEY _____	T. <u>28</u> N. S. R. <u>3E</u> 3E	E-2 E-3 F-1
2. PROPERTY CONTROLLING IN SECTION <u>5</u>	T. <u>28</u> N. S. R. <u>3</u> E. W.	Code 14
3. MISCELLANEOUS PROPERTY IN SECTION _____	T. _____ N. S. R. _____ E. W.	
4. LOT NO. _____, RECORDED PLAT _____		
5. PRIVATE CLAIMS _____		

REGISTER OF DEEDS STAMP AND FILING NUMBER

I, Kenneth J. Ostling do hereby certify that under requirements of P.A. 74, Michigan P.A. of 1970, the corner points mentioned in lines 1 and 2 above (identified with circles on index code diagram - over) were, in a field survey on 11-6 1972, established, re-established, monumented, re-monumented, recovered or restored as expressed below and in conformance with regulations and rules therefore as required in the current manual of survey instructions of the United States Department of the Interior, Bureau of Land Management or by a decree of a court of law. Furthermore, that the corner points mentioned in lines 3, 4 and 5 above were, in a field survey on _____ 19____, found, recovered, restored, established or re-established as expressed below and in conformance with the rules of the Michigan State Board of Registration for Land Surveyors or, by a Decree of a Court of law:

A. Description of original monument and accessories and/or subsequent restoration:

B. Description of corner evidence found and/or method applied in restoring or re-establishing corner:


- E-2 Set corner by proportionate measurement between section corners.
- E-3 Set corner by proportionate measurement between section corners 1 mile each direction. No U.S. evidence.
- F-1 Found pile of stones in North wheel track of E-W road. Remains of down Hemlock in place for Randall's SE NBT. Old fence line South.
- 14 Set by standard survey procedure for the subdivision of sections.

C. Description of monument for corner and accessories established to perpetuate locating the position of the corner:

E-2	E-3	F-1	Code 14
Set DNR Mon. & Cedar Post	Set DNR Mon & Cedar Post	Set DNR Mon.	Set 2' of 1" pipe
15" Maple N41E 55.3'	6" Maple N68W 7.2'	8" Maple S30E 14.5'	12" R.Oak N65W 4.0'
8" Maple N85E 44.6'	9" Maple S40W 35.6'	7" H. Maple S60E 35.2'	9" R.Oak N13E 8.0'
		S& Sec. 33 East 20.5'	

SIGNED BY Kenneth J. Ostling DATE _____

SURVEYOR'S MICHIGAN REGISTRATION NO. 10068

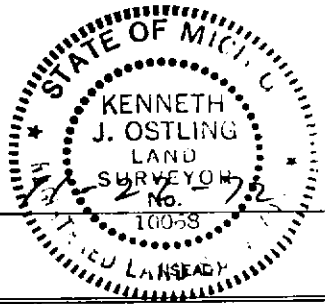

FOR STATE AND UNITED STATES AGENCIES:

SIGNED BY _____ DATE _____
CHIEF OF SURVEY PARTY

APPROVED AND SIGNED BY _____ DATE _____
MICHIGAN REGISTERED LAND SURVEYOR (SEAL)

SURVEYOR'S MICHIGAN REGISTRATION NO. _____