

B3C0DA ✓

LAND CORNER RECORDATION CERTIFICATE

FILING REQUIREMENT OF ACT 74, MICH. P.A.1970

FOR CORNERS OF--:	LOCATED IN--:	CORNER CODE NUMBER
1. PUBLIC LAND SURVEY _____	T. <u>28</u> N. <u>3</u> E. <u>3</u>	B-3, C-4, D-3
2. PROPERTY CONTROLLING IN SECTION _____	T. _____ N. _____ S. _____ R. _____ E. _____ W. _____	_____
3. MISCELLANEOUS PROPERTY IN SECTION _____	T. _____ N. _____ S. _____ R. _____ E. _____ W. _____	_____
4. LOT NO. _____, RECORDED PLAT _____		
5. PRIVATE CLAIMS _____		

REGISTER OF DEEDS STAMP AND FILING NUMBER

I, Kenneth J. Ostling do hereby certify that under requirements of P.A. 74, Michigan P.A. of 1970, the corner points mentioned in lines 1 and 2 above (identified with circles on index code diagram - over) were, in a field survey on 11-30 1972, established, re-established, monumented, re-monumented, recovered or restored as expressed below and in conformance with regulations and rules therefore as required in the current manual of survey instructions of the United States Department of the Interior, Bureau of Land Management or by a decree of a court of law. Furthermore, that the corner points mentioned in lines 3, 4 and 5 above were, in a field survey on _____ 19____, found, recovered, restored, established or re-established as expressed below and in conformance with the rules of the Michigan State Board of Registration for Land Surveyors or, by a Decree of a Court of law:

A. Description of original monument and accessories and/or subsequent restoration:


B. Description of corner evidence found and/or method applied in restoring or re-establishing corner:

- B-3 Set corner by proportionate measurement between section corners. No evidence of previous corner.
- C-4 Set corner by proportionate measurement between section corners. No previous corner.
- D-3 Set corner by proportionate measurement, midpoint on line between section corners.

C. Description of monument for corner and accessories established to perpetuate locating the position of the corner:

B-3		C-4		D-3	
Set DNR MOn & Cedar Post		Set DNR Monument		Set DNR Mon & Cedar Post	
15" Tw. R. Pine	S59W 71.3'	10" W. Pine	N17W 41.7'	14" R. Pine	S15W 66.4'
4" J. Pine	N17W 66.9'	11" Tw.R. Pine	S68W 38.7'	10" R. Pine	N46W 61.9'
				21" R.P. Stp	S80E 41.3'

SIGNED BY Kenneth Ostling DATE _____
 SURVEYOR'S MICHIGAN REGISTRATION NO. 10068

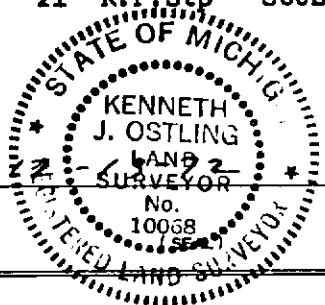

FOR STATE AND UNITED STATES AGENCIES:

SIGNED BY _____ DATE _____
CHIEF OF SURVEY PARTY

APPROVED AND SIGNED BY _____ DATE _____
MICHIGAN REGISTERED LAND SURVEYOR

(SEAL)

SURVEYOR'S MICHIGAN REGISTRATION NO. _____