

LAND CORNER RECORDATION CERTIFICATE
Filing Requirement of Act 74, Mich. P.A. 1970

For corners in

<u>Oscoda</u> <small>(County)</small>	Located In:	Corner Code #
1. Public Land Survey	T _____ R _____	_____
	T _____ R _____	_____
	T _____ R _____	_____
	T _____ R _____	_____
2. Property Controlling in Section	S <u>29</u> T <u>28N</u> R <u>3E</u>	<u>15</u>
	S <u>29</u> T <u>28N</u> R <u>3E</u>	<u>11</u>
3. Miscellaneous Property in Sec.	S _____ T _____ R _____	_____
	S _____ T _____ R _____	_____

Register of Deeds Stamp & File Number

4. Lot No. _____, Recorded Plat _____
 5. Private Claims _____

I, Carl R. Johnson, in a field survey on August 4, 8, 1988, do hereby certify that under requirements of P.A. 74, Michigan P.A. of 1970, the corner points mentioned in lines 1 and 2 above were in conformance with regulations and rules therefore as required in the current manual of survey instructions of the United States Department of the Interior, Bureau of Land Management or by a decree of a Court of Law and/or that the corner points mentioned in lines 3, 4 and 5 above were in conformance with the rules of the Michigan Board of Land Surveyors or by a Decree of a Court of Law; established, re-established, monumented, re-monumented, recovered, found as expressed below:

NOTE: Not more than 4 corners, all in the same town and range, may be recorded on this certificate.

	A	B	C	D	E	F	G	H	I	J	K	L	M
2	6	5	4	3	2	1							
3													
4	7	8	9	10	11	12							
5													
6	18	17	16	15	14	13							
7													
8	19	20	21	22	23	24							
9													
10	30	29	28	27	26	25							
11													
12	31	32	33	34	35	36							
13													

A. Description of original monument and accessories and/or subsequent restoration:


B. Description of corner evidence found and/or method applied in restoring or reestablishing corner:

- 15 - This corner was established this survey, set by standard survey procedure for the subdivision of a section. Apparently misplaced approx. 2 feet east in survey of 1972.
- 11 - Corner set by standard survey procedure for subdivision of a section.

C. Description of monument for corner and accessories established to perpetuate locating the position of the corner:

<u>15 - W 1/8, S. side</u>	<u>11 - Center of SW 1/4</u>
Set 1 inch pipe, cedar post	Set 5/8" bar w/cap, cedar post
Maple 8" S14°W 46.4'	14" Maple N24°W 26.35 ft.
Maple 6" S50°E 56.3'	7" Ironwood S74°W 57.35 ft.
	16" Maple S14°E 56.97 ft.

Signed by Carl R. Johnson
 Surveyor's Michigan License No. 30083

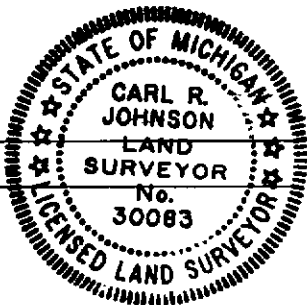

Date 9/12/88