

LAND CORNER RECORDATION CERTIFICATE
Filing Requirement of Act 74, Mich. P.A. 1970

For corners in
Oscoda
(County)

Located In: _____ Corner Code \neq _____

- | | | |
|---------------------------------------|---------------------------------------|-------------|
| 1. Public Land Survey | T <u>28</u> N R <u>3E</u> | <u>D-10</u> |
| | T _____ R _____ | _____ |
| | T _____ R _____ | _____ |
| | T _____ R _____ | _____ |
| 2. Property Controlling
in Section | S <u>29</u> T <u>28</u> N R <u>3E</u> | <u>8</u> |
| | S <u>32</u> T <u>28</u> N R <u>3E</u> | <u>4</u> |
| 3. Miscellaneous
Property in Sec. | S _____ T _____ R _____ | _____ |
| | S _____ T _____ R _____ | _____ |

Register of Deeds Stamp & File Number

4. Lot No. _____, Recorded Plat _____
5. Private Claims _____

	A	B	C	D	E	F	G	H	I	J	K	L	M
2	6		5		4		3		2		1		
3													
4	7		8		9		10		11		12		
5													
6	18		17		16		15		14		13		
7													
8	19		20		21		22		23		24		
9													
10	30		29		28		27		26		25		
11													
12	31		32		33		34		35		36		
13													

I, Carl R. Johnson, in a field survey on August 8, 19 88, do hereby certify that under requirements of P.A. 74, Michigan P.A. of 1970, the corner points mentioned in lines 1 and 2 above were in conformance with regulations and rules therefore as required in the current manual of survey instructions of the United States Department of the Interior, Bureau of Land Management or by a decree of a Court of Law and/or that the corner points mentioned in lines 3, 4 and 5 above were in conformance with the rules of the Michigan Board of Land Surveyors or by a Decree of a Court of Law; established, re-established, monumented, re-monumented, recovered, found as expressed below:

NOTE: Not more than 4 corners, all in the same town and range, may be recorded on this certificate.

A. Description of original monument and accessories and/or subsequent restoration:

B. Description of corner evidence found and/or method applied in restoring or reestablishing corner:


- D-10 - Corner set by standard survey procedure for subdivision of a section.
- 8 - Corner set by standard survey procedure for subdivision of a section.
- 4 - Corner set by standard survey procedure for subdivision of a section.

C. Description of monument for corner and accessories established to perpetuate locating the position of the corner:

- | | |
|---------------------------------|---------------------------------------|
| <u>D-10 Center of Section</u> | <u>8 - W 1/8 cor. on E-W 1/4 line</u> |
| Set 5/8" bar w/cap & cedar post | Set 5/8" bar w/cap & cedar post |
| 16" Maple S58°E 50.50 ft. | 10" Oak S40°W 32.89 ft. |
| 20" Twin Maple S13°W 45.37 ft. | 14" Beech N57°E 55.47 ft. |
| Fence cor. N37°W 28.6 ft. | Fence cor. N 52°W 17.5 ft. |

- 4 - Center of NW 1/4
Set 5/8" rod w/cap & cedar Post
6" Maple S69°W 47.2'
6" Beech N29°W 60.0'

Signed by Carl R. Johnson
Surveyor's Michigan License No. 30083

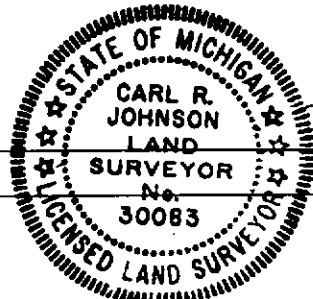

Date 9/12/88