

# LAND CORNER RECORDATION CERTIFICATE

Filing Requirement of Act 74, Mich. PA 1970

For Corners In: Oscoda Located In \_\_\_\_\_ Corner Code # \_\_\_\_\_  
 (County)



1. Public Land Survey T 28N R 3E D-7  
 T \_\_\_\_\_ R \_\_\_\_\_  
 2. Property Controlling in Section S \_\_\_\_\_ T \_\_\_\_\_ R \_\_\_\_\_  
 S \_\_\_\_\_ T \_\_\_\_\_ R \_\_\_\_\_  
 3. Miscellaneous Property in Section S \_\_\_\_\_ T \_\_\_\_\_ R \_\_\_\_\_  
 S \_\_\_\_\_ T \_\_\_\_\_ R \_\_\_\_\_

4. Lot No: \_\_\_\_\_ Recorded Plat: \_\_\_\_\_

5. Private Claims: \_\_\_\_\_

I, Carl T. Kiiskila, in a field survey on August 8, 2001 do hereby state that under requirements of PA 74, Michigan PA of 1970, the corner points mentioned in lines 1 and 2 above were in conformance with regulations and rules therefore as required in the current manual of survey instructions of the United States Department of the Interior, Bureau of Land Management or by a decree of a Court of Law and/or that the corner points mentioned in lines 3, 4 and 5 above were in conformance with the rules of the Michigan Board of Land Surveyors or by a Decree of a Court of Law; established, re-established, monumented, recovered, found as expressed below:

**NOTE: Not more than 2 corners, all in the same town and range, may be recorded on this certificate.**

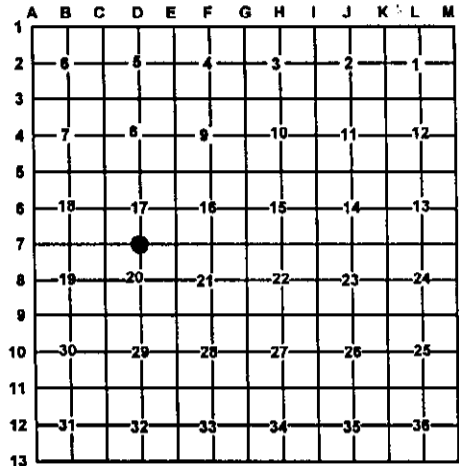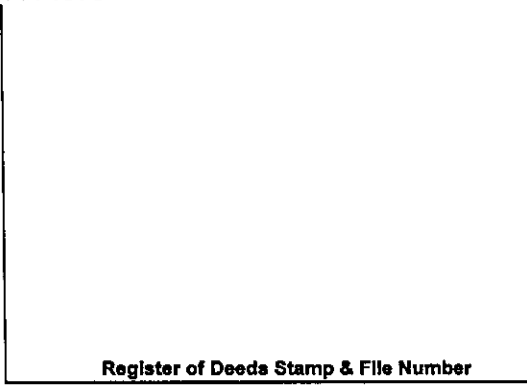

**A. Description of original monument and accessories and/or subsequent restoration:**

D-7 G.L.O. William R. Coon D.S. 1839  
 Set quarter section post  
 Wit: Birch 8" N21°W 6.5 links  
 Aspen 6" N35°E 9.5 links

In July of 2001 we reran the line common to section 17 and 20 and found the 1/4 corner common to section 17 and 20 was incorrectly set. We moved the existing monument to the correct intended position midway and online between section corners

This corner was first re-established by Kenneth Ostling P.S. #10068 by proportionate measurement between section corners. The corner was moved to conform with a new position for the corner common to sections 17, 18, 19 and 20 in December of 1974. In January of 2000 Larry M. Gerschbacher, P.S. #18990 sent me a letter stating the 1/4 corner between section 17 and 20 appears to be misplaced approximately 36' West and 2' South of a midway and on line the way as our drawing represents.

**B. Description of corner evidence found and/or method applies in restoring or re-establishing corner:**  
 D-7 Moved the existing D.N.R. monument to its correct position midway and online between C-7 and E-7

**C. Description of monument for corner and accessories established to perpetuate locating the position of the corner:**

D-7 Set D.N.R. monument  
 Wit: 7" Maple East 26.42'  
 6-8" Twin Maple S60°W 4.22'  
 6-8" Twin Maple South 36.36'  
 7" Maple North 23.20'



Signed by: Carl T. Kiiskila  
 Surveyor's Michigan License No.: 33981

Date: 12-3-01