

**SURVEY & REMONUMENTATION**

MAR 19 1997

COMMISSION

*Liber 4 Pg 117*

**LAND CORNER RECORDATION CERTIFICATE**  
**Filing Requirement of Act 74, Mich. P.A. 1970**

STATE OF MICHIGAN  
 OSCODA COUNTY  
 FILED

For corners in  
Oscoda  
 (County)

Located In:  
 Clinton Twp.

Corner Code #

17 SEP 96 9:47 A.M.

PATSY J. PETERS  
 REGISTER OF DEEDS

- |                                      |   |            |   |           |            |
|--------------------------------------|---|------------|---|-----------|------------|
| 1. Public Land Survey                | T | <u>28N</u> | R | <u>4E</u> | <u>F-1</u> |
|                                      | T | _____      | R | _____     | _____      |
|                                      | T | _____      | R | _____     | _____      |
|                                      | T | _____      | R | _____     | _____      |
| 2. Property Controlling in Section   | S | _____      | T | _____     | R          |
|                                      | S | _____      | T | _____     | R          |
| 3. Miscellaneous Property in Section | S | _____      | T | _____     | R          |
|                                      | S | _____      | T | _____     | R          |

LIBER 196 PAGE 5702

Register of Deeds Stamp & File Number

4. Lot No. \_\_\_\_\_, Recorded Plat \_\_\_\_\_  
 5. Private Claims \_\_\_\_\_

A	B	C	D	E	F	G	H	I	J	K	L
2	6	5	4	3	2	1					
3											
4	7	8	9	10	11	12					
5											
6	18	17	16	15	14	13					
7											
8	19	20	21	22	23	24					
9											
10	30	29	28	27	26	25					
11											
12	31	32	33	34	35	36					
13											

I, Larry G. Beauregard, in a field survey on July, 19 96, do hereby certify that under requirements of P.A. 74, Michigan P.A. of 1970, the corner points mentioned in lines 1 and 2 above were in conformance with regulations and rules therefore as required in the current manual of survey instructions of the United States Department of the Interior, Bureau of Land Management or by a decree of a Court of Law and/or that the corner points mentioned in lines 3, 4 and 5 above were in conformance with the rules of the Michigan Board of Professional Surveyors or by a Decree of a Court of Law; established, re-established, monumented, re-monumented, recovered, found as expressed below:

NOTE: Not more than 4 corners, all in the same town and range, may be recorded on this certificate.

A. Description of original monument and accessories and/or subsequent restoration:


F-1 North  $\frac{1}{2}$  corner Section 4.  
 No corner set on original survey.  
 No Act 74 recorded.  
 No Act 132 recorded.  
 No corner found from subsequent surveys.

B. Description of corner evidence found and/or method applied in restoring or reestablishing corner:

I set Oscoda Co. std. corner, 3" brass cap on 1" x 3' pipe by single proportion on Co. line between section corners. This corner is 7.34' feet West of std corner S.  $\frac{1}{2}$  corner Section 33, T 29N, R 4E.

**APPROVED**  
 County Remonumentation  
 Peer Review Group

*NCC*  
*9 SEPT 96*

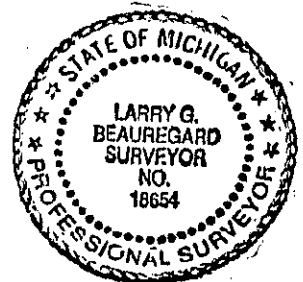

C. Description of monument for corner and accessories established to perpetuate locating the position of the corner:

North  $\frac{1}{2}$  corner Section 4  
 Oscoda Co. std corner 3" brass cap on 1" x 3' pipe. Accepted as a careful and faithful establishment of the position of the corner. Approved by the Peer Group on July 12, 1996.  
 East 7.34' Concrete Monument std. Cor. S.  $\frac{1}{2}$  Cor. Sec. 33, T 29N, R 4E.  
 N 60° E 16.78' Tw. 16" R. Oak  
 S 45° W 68.90' Tw. 17" R. Oak  
 S 70° W 80.37' 7" Maple in clump of four  
 N 70° W 72.85' 10" R. Oak

Placed 60d penny spike and P.S. tag #18654 (typ)

Signed by Larry G. Beauregard Date 9-4-1996  
 Surveyor's Michigan License No. 18654