

MICHIGAN
DEPARTMENT OF CONSERVATION
FORESTRY DIVISION

LAND CORNER RECORD


T. 28 N.R. 1 W
T. 29 N.R. 1 W Crawford
Otsego COUNTY

DESCRIPTION OF CORNER Section corner common to Sections 2-3-34-35

CORNER MONUMENT Reset Brass Cap Monument

DATE MONUMENT PLACED AND WITNESSED April 1968

WITNESSES TO CORNER.....

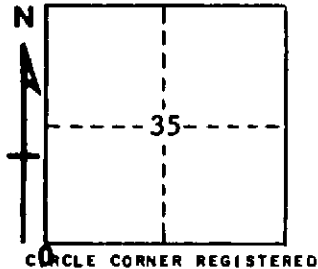

12" Oak S 53 E 16.8'
7" Oak S 86 W 46.2'
AND
8" J. Pine N 60 E 17.8'

DESCRIPTION IN DETAIL AS TO HOW CORNER WAS LOCATED AND IDENTIFIED OR RESTORED.

This corner was corrected from its 1953 position during a partial retracement in this area. This corner was originally established by single proportionate measurement. However, measurement to good corners north and stream crossing south strongly supported a double proportion procedure, which would place the corner some 102' south of original position and much more in conformity with the U.S. field notes. Also results in a better distribution of available lands and provides a much more acceptable pattern of survey for adjacent sections. Considered it practical to adjust two corners at this time to avoid future problems.

SURVEYOR'S SEAL

SIGNED

Rebecca J. Belling
REGISTERED LAND SURVEYOR #10068

DATE

6/27/68