

MICHIGAN  
DEPARTMENT OF CONSERVATION  
FORESTRY DIVISION

LAND CORNER RECORD


T. 28 N.R. 1 W  
T. 29 N.R. 1 W Crawford  
Otago COUNTY

DESCRIPTION OF CORNER Sec. corner common to Sections 4-5-32-33

CORNER MONUMENT Set, Cons, Dept, Mon.

DATE MONUMENT PLACED AND WITNESSED 4/12/68

WITNESSES TO CORNER.....

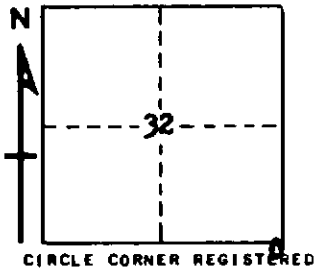

6" R. Pine S 58 W 76.1  
9" R. Pine N 60 E 32.5  
AND  
\* 24" R. Pine S 50 E 103.7  
\* E. S. Houghton 1914 NBT

DESCRIPTION IN DETAIL AS TO HOW CORNER WAS LOCATED AND IDENTIFIED OR RESTORED.

This corner was restored from Houghton witness of record, as established in 1914 survey. Could not locate stake bottom in extensive excavation, but believe this to be a perpetuation of old corner.

SURVEYOR'S SEAL

SIGNED *Kenneth Witting* DATE 4/22/68  
REGISTERED LAND SURVEYOR #10068