

MICHIGAN  
DEPARTMENT OF CONSERVATION  
FORESTRY DIVISION

# LAND CORNER RECORD

T. 29 N.R. 1 W


Otsego COUNTY

DESCRIPTION OF CORNER 1/4 Corner common to Sections 30-31

CORNER MONUMENT Set Cons. Dept. Mon.

DATE MONUMENT PLACED AND WITNESSED 4/12/68

WITNESSES TO CORNER.....

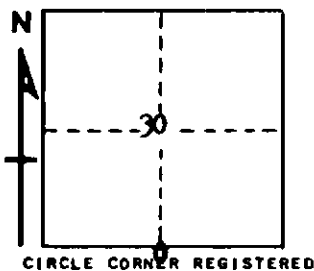

	<u>8" R. Pine</u>	<u>S 19 E</u>	<u>55.3</u>
	<u>* 10" Dead J. Pine</u>	<u>S 45 E</u>	<u>17.5</u>
AND	<u>12" B. Oak</u>	<u>N 14 E</u>	<u>17.5</u>
	<u>* E.S. Houghton 1926 NBT</u>		

DESCRIPTION IN DETAIL AS TO HOW CORNER WAS LOCATED AND IDENTIFIED OR RESTORED.

This corner was found during a retracement in this area. Found Houghton's stake bottom and witnesses as established in 1926 survey of Section 30. Unable to identify U.S.B.T.s, but is best available evidence.

SURVEYOR'S SEAL

SIGNED *Carroll H. Kellogg* DATE 4/22/68  
REGISTERED LAND SURVEYOR #10068