

MICHIGAN
DEPARTMENT OF CONSERVATION
FORESTRY DIVISION

LAND CORNER RECORD

T. 29 N.R. 1 W


Otsego COUNTY

DESCRIPTION OF CORNER Sec. corner common to sections 29=30=31=32

CORNER MONUMENT Set Cons. Dept. Mon.

DATE MONUMENT PLACED AND WITNESSED 4/12/68

WITNESSES TO CORNER.....

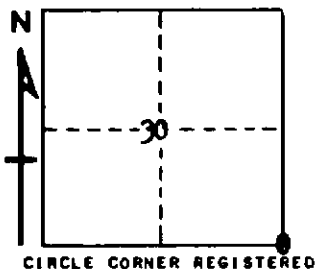

9" J. Pine N 72 W 47.1

8" B. Oak S 6 E 33.4

AND * 12" J. Pine N 53 W 106.0

* E. S. Houghton 1926 NBT

DESCRIPTION IN DETAIL AS TO HOW CORNER WAS LOCATED AND IDENTIFIED OR RESTORED.

This corner was found during a retracement in this area.

Found Houghton post and witness as established in 1926 survey. U.S.B.T.s all gone. Falls in old N-S fence line. Best available evidence.

SURVEYOR'S SEAL

SIGNED *Kenneth W. Keith* DATE 4/12/68
REGISTERED LAND SURVEYOR #10068