

MICHIGAN
DEPARTMENT OF CONSERVATION
FORESTRY DIVISION

LAND CORNER RECORD


T. 29 N.R. 1 W
T. 28 N.R. 1 W Otsego
Crawford COUNTY

DESCRIPTION OF CORNER 1/4 corner common to Sections 33, 4

CORNER MONUMENT Set Cons. Dept. Mon.

DATE MONUMENT PLACED AND WITNESSED 5/7/68

WITNESSES TO CORNER.....

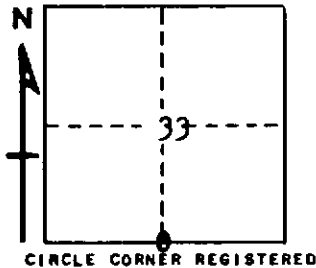

9" J. Pine N 63 E 31.0

9" R. Oak N 80 W 32.1

AND

DESCRIPTION IN DETAIL AS TO HOW CORNER WAS LOCATED AND IDENTIFIED OR RESTORED.

This corner was set by proportionate measurement, midpoint on line, between section corners. No original evidence.

SURVEYOR'S SEAL

SIGNED *Marion H. Helling* DATE 5/10/68
REGISTERED LAND SURVEYOR #10068