

MICHIGAN
DEPARTMENT OF CONSERVATION
FORESTRY DIVISION

LAND CORNER RECORD

T. 28 N.R. 1 W
T. 29 N.R. 1 W


Otsego
Crawford COUNTY

DESCRIPTION OF CORNER 1/4 corner common to sections 3-34

CORNER MONUMENT Set Cons. Dept. Monument

DATE MONUMENT PLACED AND WITNESSED 5/6/68

WITNESSES TO CORNER.....

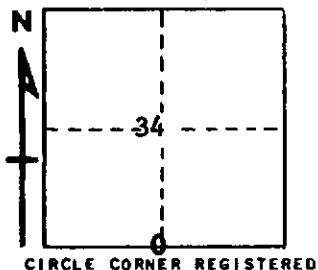

6" Oak N 72 E 64.1'
6" Oak N 8 E 95.3'
AND
7" J. Pine N 38 W 22.5'

DESCRIPTION IN DETAIL AS TO HOW CORNER WAS LOCATED AND IDENTIFIED OR RESTORED.

This corner was set by proportionate measurement between section corners during a survey in this area. No. U. S. evidence.

SURVEYOR'S SEAL

SIGNED *Walter Hitting* DATE 6/27/68
REGISTERED LAND SURVEYOR #10068