

MAR 17 2000

SECTION

OTSEGO COUNTY REMONUMENTATION

LAND CORNER RECORDATION CERTIFICATE
Filing Requirement of Act 74, Mich. P.A. 1970
Also Act 345, PA 1990

OTSEGO COUNTY MICHIGAN RECEIVED FOR RECORD

99 DEC 27 PM 2:54

EVELYN H. PRATT CLERK / REGISTER OF DEEDS

For corners in

Form with fields for County (Otsego), Located In, Corner Code # (H-13), and numbered sections 1-5 for describing the survey and claims.

Register of Deeds Stamp & File Number

Grid table with columns A-M and rows 1-13, containing numbers 1-36.

I, James L. Schwandt, in a field survey on Jan. 19, 1999, do hereby state that under requirements of P.A. 74, Michigan P.A. of 1970, the corner points mentioned in lines 1 and 2 above were in conformance with regulations and rules therefore as required in the current manual of survey instructions of the United States Department of the Interior, Bureau of Land Management or by a decree of a Court of Law and/or that the corner points mentioned in lines 3, 4 and 5 above were in conformance with the rules of the Michigan Board of Land Surveyors or by a Decree of a Court of Law; established, re-established, monumented, recovered, found as expressed below:

NOTE: Not more than 4 corners, all in the same town and range, may be recorded on this certificate.

A. Description of original monument and accessories and/or subsequent restoration:


G.L.O. James Mullett, 1839 Aspen 12" for Post Resurvey by Harvey Mellen, 1856 Set Post Spruce Pine 4", N23°E, 50 links Spruce Pine 4", S48°E, 7 links Kenneth Ostling set Conservation Department Monument, 05-06-68 Recorded by S. Thorson, 10-29-68 Oak 6", N72°E, 64.1' Oak 6", N8°E, 95.3' J. Pine 7", N38°W, 22.5' Set by proportionate measure No U.S. evidence

B. Description of corner evidence found and/or method applied in restoring or reestablishing corner:

Found Department of Conservation Monument, 1" pipe with brass cap from 1968 Found 1968, 12" J. Pine, N38°W, 22.5'

C. Description of monument for corner and accessories established to perpetuate locating the position of the corner:

Department of Conservation Monument in corner is accepted as a careful and faithful reestablishment of the position of the original corner. P.K. nail in 12" J. Pine, N38°W, 22.50' P.K. nail in 8" J. Pine, S45°E, .70' P.K. nail in 10" J. Pine, N60°E, 26.40' P.K. nail in 6" J. Pine, S58°W, 11.39'

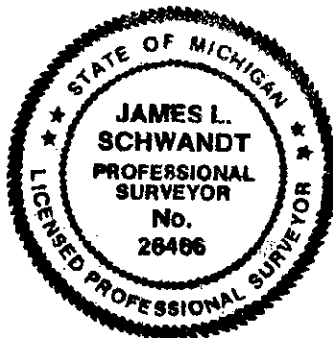

OTSEGO COUNTY REMONUMENTATION

Approved by the County Survey Peer Group, pursuant to Act 345, PA 1990. Dec. 17, 1999 Date Chairman

Signed by James L. Schwandt Date 12-13-99 Surveyor's Michigan License No. 26466

LIBER A PAGE 772