

MAR 17 2000

**OTSEGO COUNTY REMONUMENTATION**

**SECTION**

**LAND CORNER RECORDATION CERTIFICATE**  
**Filing Requirement of Act 74, Mich. P.A. 1970**  
**Also Act 345, PA 1990**

OTSEGO COUNTY  
 MICHIGAN  
 RECEIVED FOR RECORD

99 DEC 27 PM 2:56

EVELYN M. PRATT  
 CLERK / REGISTER OF DEEDS

For corners in

<u>Otsego</u> (County)	Located In:	Corner Code #	
1. Public Land Survey	T <u>29N</u> R <u>1W</u>	<u>I-13</u>	
	T _____ R _____	_____	
	T _____ R _____	_____	
	T _____ R _____	_____	
2. Property Controlling in Section	S _____ T _____ R _____	_____	
	S _____ T _____ R _____	_____	
3. Miscellaneous Property in Sec.	S _____ T _____ R _____	_____	
	S _____ T _____ R _____	_____	
4. Lot No. _____, Recorded Plat _____			
5. Private Claims _____			

Register of Deeds Stamp & File Number

I, James L. Schwandt, in a field survey on Jan. 19, 1999, do hereby state that under requirements of P.A. 74, Michigan P.A. of 1970, the corner points mentioned in lines 1 and 2 above were in conformance with regulations and rules therefore as required in the current manual of survey instructions of the United States Department of the Interior, Bureau of Land Management or by a decree of a Court of Law and/or that the corner points mentioned in lines 3, 4 and 5 above were in conformance with the rules of the Michigan Board of Land Surveyors or by a Decree of a Court of Law; established, re-established, monumented, recovered, found as expressed below:

**NOTE: Not more than 4 corners, all in the same town and range, may be recorded on this certificate.**

	A	B	C	D	E	F	G	H	I	J	K	L	M
1													
2	6		5		4		3		2		1		
3													
4	7		8		9		10		11		12		
5													
6	18		17		16		15		14		13		
7													
8	19		20		21		22		23		24		
9													
10	30		29		28		27		26		25		
11													
12	31		32		33		34		35		36		
13													

**A. Description of original monument and accessories and/or subsequent restoration:**


G.L.O. James Mullett, 1839 Set post Pine 6", N2.5°W, 56 links Pine 6", N22°E, 56 links	Dean Delamater, 02-20-53 Set 1" pipe with 4" brass cap 5" J. Pine, N23°W, 8 links 5" J. Pine, S50°W, 5 links	Kenneth Ostling, 04-19-68 Reset brass cap, corrected from its 1953 position 12" Oak, S53°E, 16.8' 7" Oak, S86°W, 46.2' 8" J. Pine, N60°E, 17.8' Reset due to additional ties and stream Crossing. Conforms closer to G.L.O. notes.
---	---	--

**B. Description of corner evidence found and/or method applied in restoring or reestablishing corner:**

Found Department of Conservation Monument, 1" pipe with brass cap from 1968  
 Found 10" J. Pine, N60°E, 17.8' to face  
 Found 15" Black Oak, S53°E, 16.8' to face

**C. Description of monument for corner and accessories established to perpetuate locating the position of the corner:**

Department of Conservation Monument in corner is accepted as a careful and faithful reestablishment of the position of the original corner.  
 Spike in found 10" J. Pine, N60°E, 18.28'  
 Spike in found 15" Black Oak, S53°E, 17.18'  
 Spike in 6" J. Pine, N20°W, 4.78'  
 Spike in 8" J. Pine, S69°W, 18.58'

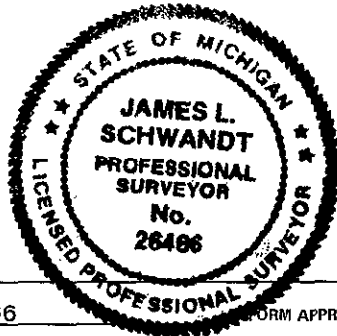

**OTSEGO COUNTY REMONUMENTATION**

Approved by the County Survey Peer Group, pursuant to Act 345, PA 1990  
 Dec. 17, 1999 *[Signature]*  
 Date Chairman

Signed by *[Signature]*  
 Surveyor's Michigan License No. 26466

Date 12-23-99