

MAR 17 2000

OTSEGO COUNTY REMONUMENTATION

SECTION

LAND CORNER RECORDATION CERTIFICATE
Filing Requirement of Act 74, Mich. P.A. 1970
Also Act 345, PA 1990

OTSEGO COUNTY MICHIGAN
RECEIVED FOR RECORD

99 DEC 27 PM 2:56

EVELYN M. PRATT
CLERK / REGISTER OF DEEDS

For corners in

Form with fields for Otsego (County), Located In: (Town/Range/Section), Corner Code #, and numbered items 1-5 describing the survey and claims.

Register of Deeds Stamp & File Number

Grid table with columns A-M and rows 1-13, containing numbers 1-36.

I, James L. Schwandt, in a field survey on Jan. 19, 1999, do hereby state that under requirements of P.A. 74, Michigan P.A. of 1970, the corner points mentioned in lines 1 and 2 above were in conformance with regulations and rules therefore as required in the current manual of survey instructions of the United States Department of the Interior, Bureau of Land Management or by a decree of a Court of Law and/or that the corner points mentioned in lines 3, 4 and 5 above were in conformance with the rules of the Michigan Board of Land Surveyors or by a Decree of a Court of Law; established, re-established, monumented, recovered, found as expressed below:

NOTE: Not more than 4 corners, all in the same town and range, may be recorded on this certificate.

A. Description of original monument and accessories and/or subsequent restoration:


G.L.O. James Mullett, 1839 Set post Spruce 10", N58°E, 4 links Spruce 12", N33°W, 20 links
Kenneth Ostling set Conservation Department Monument 05-06-68 Recorded by S. Thorson 10-29-68 7" Cedar, N23°E, 109.3' 6" Cedar, N6°E, 96.7' 6" Tamarack, S87°E, 31.3' Set by proportionate measurement. No U.S. evidence

B. Description of corner evidence found and/or method applied in restoring or reestablishing corner:

Found Department of Conservation Monument, 1" pipe with brass cap from 1968
Found 9" Tamarack East 31.3' to face
Found 12" Cedar, N20°E, 108.6' to face

C. Description of monument for corner and accessories established to perpetuate locating the position of the corner:

Department of Conservation Monument in corner is accepted as a careful and faithful reestablishment of the position of the original corner.
Spike in found 9" Tamarack East 31.31'
Spike in found 12" Cedar, N20°E, 108.80'
Spike in 4" Spruce East, 1.85'
Spike in 6" Spruce, N78°W, 17.51'

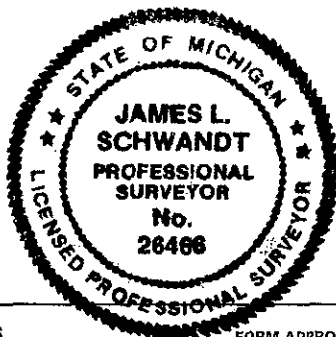

OTSEGO COUNTY REMONUMENTATION

Approved by the County Survey Peer Group, pursuant to Act 345, PA 1990.

Dec. 17, 1999 Date [Signature] Chairman

Signed by James L. Schwandt
Surveyor's Michigan License No. 26466

Date 12-13-99