

LAND CORNER RECORDATION CERTIFICATE

Filing Requirement of Act 74, Mich. PA 1970

For Corners In: <u>Ossego</u> (County)	Located In T _____ R _____ T _____ R _____	Corner Code # _____ _____
1. Public Land Survey	T _____ R _____ T _____ R _____	_____ _____
2. Property Controlling in Section	S 36 T 29N R 1W S _____ T _____ R _____	2 _____
3. Miscellaneous Property in Section	S _____ T _____ R _____ S _____ T _____ R _____	_____ _____

4. Lot No: _____ Recorded Plat: _____

5. Private Claims: _____

I, Carl T. Kiiskila, in a field survey on June 23, 2003 do hereby state that under requirements of PA 74, Michigan PA of 1970, the corner points mentioned in lines 1 and 2 above were in conformance with regulations and rules therefore as required in the current manual of survey instructions of the United States Department of the Interior, Bureau of Land Management or by a decree of a Court of Law and/or that the corner points mentioned in lines 3, 4 and 5 above were in conformance with the rules of the Michigan Board of Land Surveyors or by a Decree of a Court of Law; established, re-established, monumented, recovered, found as expressed below:

NOTE: Not more than 2 corners, all in the same town and range, may be recorded on this certificate.

Register of Deeds Stamp & File Number

	A	B	C	D	E	F	G	H	I	J	K	L	M
1													
2	6	5	4	3	2	1							
3													
4	7	8	9	10	11	12							
5													
6	18	17	16	15	14	13							
7													
8	19	20	21	22	23	24							
9													
10	30	29	28	27	26	25							
11													
12	31	32	33	34	35	36							
13													

A. Description of original monument and accessories and/or subsequent restoration:

2- This corner position was not established during the original government survey.


B. Description of corner evidence found and/or method applies in restoring or re-establishing corner:

2- Established the Northwest corner of the Northeast quarter of the Northeast quarter of section 36 as per B.L.M. instructions for the subdivision of a section.

C. Description of monument for corner and accessories established to perpetuate locating the position of the corner:

2- Set 5/8" X 32" capped iron rod with P.S. cap #33981

Wit: 8" J. Pine	N79°E	40.02'
8" Oak	S39°E	34.20'
7" R. Pine	S48°W	37.66'
4" Oak	N34°E	19.69'
1/2" CIR	East	1.27'
Carsonite Post	North	1'

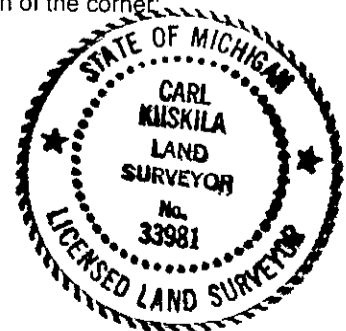

Signed by: Carl T Kiiskila
 Surveyor's Michigan License No.: 33981

Date: 11-18-03