

LAND CORNER RECORDATION CERTIFICATE
Filing Requirement of Act 74, Mich. P.A. 1970

For corners in

<u>Otsego</u> (County)	Located In:	Corner Code #
1. Public Land Survey	T 29N R 2W	L-7
	T R	
2. Property Controlling in Section	S 13 T 29N R 2W	15
	S T R	
3. Miscellaneous Property in Sec.	S T R	
	S T R	

4. Lot No. _____, Recorded Plat _____

5. Private Claims _____

I, Carl T. Kiiskila, in a field survey on July 14, 19 99 do hereby state that under requirements of P.A. 74, Michigan P.A. of 1970, the corner points mentioned in lines 1 and 2 above were in conformance with regulations and rules therefore as required in the current manual of survey instructions of the United States Department of the Interior, Bureau of Land Management or by a decree of a Court of Law and /or that the corner points mentioned in lines 3, 4 and 5 above were in conformance with the rules of the Michigan Board of Land Surveyors or by a Decree of a Court of Law; established, re-established, monumented, recovered, found as expressed below:

NOTE: Not more than 2 corners, all in the same town and range, may be recorded on this certificate.

A. Description of original monument and accessories and/or subsequent restoration:

L-7 GLO set quarter section post - Harvey Mellen, D.S. - 15 - This corner position was not established during the original Oct. 1856. government survey.
 Wit: White Birch 8" S 25° W 33 links
 White Pine 9" N 35° W 3 links

K.J. Ostling, RLS #10068, set a Department of Conservation monument by single proportionate measurement.

Liber 3, page 24 Terry E. Brand, LS #33969, on Dec. 13, 1988 found a Department of Conservation monument.

Wit: 11" Spruce N 80° E 9.56'
 7" Spruce S 50° W 12.97'
 26" W. Pine N 45° W 65.15'
 8" Spruce S 40° E 46.22'

B. Description of corner evidence found and/or method applied in restoring or reestablishing corner:

L-7 Found and accepted a Department of Conservation monument. 15 - Established the Southeast corner of the Southwest quarter of the Southwest quarter of Section 13 per standard B.L.M. instructions for subdivision of a section.


C. Description of monument for corner and accessories established to perpetuate locating the position of the corner:

L-7 Found a Department of Conservation monument. Set a carsonite marker post.	15 - Set a 5/8" x 32" rered with PS cap and set a carsonite marker post.
Wit: Set nail in 12" Maple S 3° E 45.03'	Wit: Set nail in 3" Maple S 19° E 34.89'
Set nail in 26" White Pine N 44° W 62.13'	Set nail in 4" Spruce S 43° W 56.95'
Set nail in 3" Spruce N 76° W 16.57'	Set nail in 7" Spruce N 10° E 19.42'
Set nail in 10" twin Maple S 56° W 60.10'	Set nail in 10" Balsam N 52° W 28.97'
Carsonite post set North 1'	East-west fence South 1'
	Centerline north trail road East 90' ±
	Carsonite post set North 1'



A	B	C	D	E	F	G	H	I	J	K	L	M
1												
2	6	5	4	3	2	1						
3												
4	7	8	9	10	11	12						
5												
6	18	17	16	15	14	13						
7												
8	19	20	21	22	23	24						
9												
10	30	29	28	27	26	25						
11												
12	31	32	33	34	35	36						
13												

Signed by Carl T. Kiiskila
 Surveyor's Michigan License No. 33981

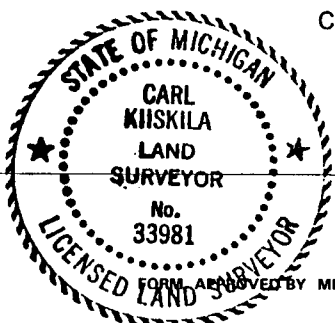

Date 8-11-99