

# LAND CORNER RECORDATION CERTIFICATE

## FILING REQUIREMENT OF ACT 74, MICH. P.A.1970

| FOR CORNERS OF--:                          | LOCATED IN--:   | CORNER CODE NUMBER      |
|--|---|-------------------------|
| 1. PUBLIC LAND SURVEY _____                | T. <u>29</u> <sup>N.</sup> <u>3</u> <sup>W.</sup>                         | <u>A-11; B-11; C-11</u> |
| 2. PROPERTY CONTROLLING IN SECTION _____   | T. _____ <sup>N.</sup> <sup>S.</sup> R. _____ <sup>E.</sup> <sup>W.</sup> | _____                   |
| 3. MISCELLANEOUS PROPERTY IN SECTION _____ | T. _____ <sup>N.</sup> <sup>S.</sup> R. _____ <sup>E.</sup> <sup>W.</sup> | _____                   |
| 4. LOT NO. _____, RECORDED PLAT _____      |   |                         |
| 5. PRIVATE CLAIMS _____                    |   |                         |

Otsego

REGISTER OF DEEDS STAMP AND FILING NUMBER

I, Kenneth J. Ostling do hereby certify that under requirements of P.A. 74, Michigan P.A. of 1970, the corner points mentioned in lines 1 and 2 above (identified with circles on index code diagram - over) were, in a field survey on June 14, 1974, established, re-established, monumented, re-monumented, recovered or restored as expressed below and in conformance with regulations and rules therefore as required in the current manual of survey instructions of the United States Department of the Interior, Bureau of Land Management or by a decree of a court of law. Furthermore, that the corner points mentioned in lines 3, 4 and 5 above were, in a field survey on \_\_\_\_\_ 19\_\_\_\_, found, recovered, restored, established or re-established as expressed below and in conformance with the rules of the Michigan State Board of Registration for Land Surveyors or, by a Decree of a Court of law:

A. Description of original monument and accessories and/or subsequent restoration:


B. Description of corner evidence found and/or method applied in restoring or re-establishing corner:

- A-11 Found rotted stake point in ground. Gnarled old beech in place for Hoffman's southwest N.B.T.; white pine stump in place for his northwest N.B.T. Bearings and distance good but his record shows 4" pine - it must have been 24".
- B-11 Found re-rod and Hoffman N.B.T.'s (white pine stumps - fair condition, markings plain.
- C-11 Found stumps in place for both O.B.T.'s. Hoffman N.B.T.'s in place southwest and northwest, but marks are grown over.

C. Description of monument for corner and accessories established to perpetuate locating the position of the corner:

| A-11                        | B-11                         | C-11                              |
|-----------------------------|------------------------------|-----------------------------------|
| DNR monument & red-top post | DNR monument & red-top post  | 2" pipe in N-S fence              |
| 12" Twin Beech N22°E 23.0   | Tri. 13" W. Birch S44°W 25.0 | 5" R. Pine N58°W 5.8              |
| 7" Beech S03°E 1.4          | Twn. 12" R. Oak N51°W 12.8   | (no mark) 12" W. Birch N79°E 60.0 |
|                             | 8" Maple N35°E 3.1           | N. shore Bradford Lake South 20'  |
|                             |                              | Cabin N.W. about 75'              |

SIGNED BY Kenneth J. Ostling DATE 7/12/74  
 SURVEYOR'S MICHIGAN REGISTRATION NO. 10068

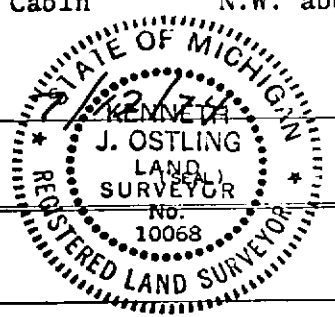

FOR STATE AND UNITED STATES AGENCIES:  
 SIGNED BY \_\_\_\_\_ DATE \_\_\_\_\_  
CHIEF OF SURVEY PARTY  
 APPROVED AND SIGNED BY \_\_\_\_\_ DATE \_\_\_\_\_  
MICHIGAN REGISTERED LAND SURVEYOR (SEAL)