LAND CORNER RECORDATION CERTIFICATE

Filing Requirement of Act 74, Mich. P.A. 1970

For corners in OTSEGO (County)

	Located In:	Corner Code ##
1. Public Land Survey	T 29N R 3W	A-4,B-4
	T ___ R ___	
	T ___ R ___	
	T ___ R ___	
2. Property Controlling	S 7 T ___ R ___	9
in Section	S ___ T ___ R ___	
3. Miscellaneous	S ___ T ___ R ___	
Property in Sec.	S ___ T ___ R ___	

Register of Deeds Stamp & File Number

4. Lot No. _____ , Recorded Plat _____

5. Private Claims _____

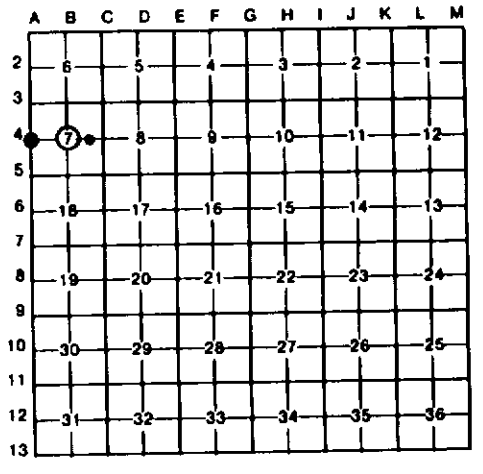

I, CARL KIISKILA , in a field survey on MAY 20 , 19 96 , do hereby certify that under requirements of P.A. 74, Michigan P.A. of 1970, the corner points mentioned in lines 1 and 2 above were in conformance with regulations and rules therefore as required in the current manual of survey instructions of the United States Department of the Interior, Bureau of Land Management or by a decree of a Court of Law and/or that the corner points mentioned in lines 3, 4 and 5 above were in conformance with the rules of the Michigan Board of Land Surveyors or by a Decree of a Court of Law; established, re-established, monumented, re-monumented, recovered, found as expressed below:

NOTE: Not more than 4 corners, all in the same town and range, may be recorded on this certificate.

A. Description of original monument and accessories and/or subsequent restoration:

A-4

(NO EVIDENCE OF G.L.O. CORNER, B.T'S, LINE TREES & TOPOGRAPHY, AS CALLED OUT IN THE G.L.O. LINE NOTES; UNLESS NOTED IN ITEM "B" BELOW.)

B-4

9

B. Description of corner evidence found and/or method applied in restoring or reestablishing corner:

A-4

FOUND AND ACCEPTED AN OTSEGO CO. MON AS SET BY C.I.ROBINSON PS #16390 FROM THE REMAINS OF WOOD POST WITH ROCKS AROUND. THIS POSITION FITS WELL WITH THE CENTER OF SECTION NOTED IN THE OTSEGO CO. SURVEY MINUTES BOOK 2, PAGES 294 AND 298.

B-4

FOUND AND ACCEPTED A 1" SQUARE HEADED BOLT AS DESCRIBED IN THE OTSEGO CO. SURVEY MINUTES PAGES 294 & 298, ALSO AS WITNESSED BY J.SCHWANDT PS FOR THE CTR OF SEC 7. SEE LIBER 319, PAGE 128 FOR HIS CERTIFICATE OF SURVEY. THE BOLT IS LOCATED ON A N-S 4' WOVEN WIRE FENCE.

9

ESTABLISHED THE SE COR OF THE SW1/4 OF THE NE1/4 OF SEC 7 PER STANDARD BLM PROCEDURE FOR THE SUBDIVISION OF A SECTION. FOUND 1/2" IRON ROD 1.03' SOUTH.

C. Description of monument for corner and accessories established to perpetuate locating the position of the corner:

A-4

FOUND OTSEGO CO. MON AND SET CARSONITE POST.

7" ASH	N73°E	26.45'
10" MAPLE CLUMP	S10°E	69.62'
‡14" CHERRY	S62°W	35.35'
8" MAPLE CLUMP	N02°E	91.34'

‡= OLD WIT BY OTHERS.

B-4

FOUND BOLT W/1" SQUARE HEAD IN N-S FENCE AND SET CARSONITE POST.

‡‡8" BEECH	S70°W	10.53'
‡‡12"&16" TW OAK	S14°W	26.52'
‡10" MAPLE	N04°E	32.13'
6" BEECH	S87°E	36.53'

‡‡=WIT BY J.SCHWANDT PS #26466
‡= OLD WIT BY OTHERS

9

SET 5/8"X32" REROD W/CAP AND CARSONITE POST.

4" MAPLE	N63°W	7.89'
5" MAPLE	N13°E	36.25'
12" MAPLE	S74°E	27.01'
14" MAPLE	S16°W	19.10'

STATE OF MICHIGAN
CARL KIISKILA
LAND SURVEYOR
No. 33981
LICENSED LAND SURVEYOR

Signed by Carl T. Kiiskila Date 2-26-97

Surveyor's Michigan License No. #33981

FORM APPROVED BY MICHIGAN STATE BOARD OF LAND SURVEYORS, JAN. 28, 1971
REVISED MAY 14, 1975
REVISED JAN., 1983