LAND CORNER RECORDATION CERTIFICATE

Filing Requirement of Act 74, Mich. P.A. 1970

For corners in OTSEGO (County)

	Located In:	Corner Code ##
1. Public Land Survey	T 29N R 3W	A-7,B-7
	T ___ R ___	
	T ___ R ___	
	T ___ R ___	
2. Property Controlling	S 18 T ___ R ___	9,16
in Section	S ___ T ___ R ___	
3. Miscellaneous	S ___ T ___ R ___	
Property in Sec.	S ___ T ___ R ___	

Register of Deeds Stamp & File Number

4. Lot No. _____ , Recorded Plat _____
5. Private Claims _____

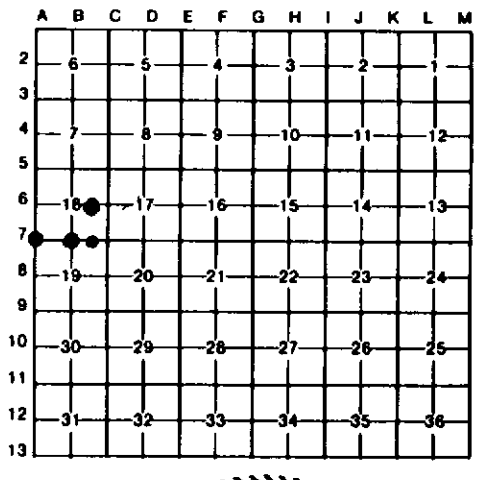

I, CARL KIISKILA, in a field survey on MAY 16, 19 96, do hereby certify that under requirements of P.A. 74, Michigan P.A. of 1970, the corner points mentioned in lines 1 and 2 above were in conformance with regulations and rules therefore as required in the current manual of survey instructions of the United States Department of the Interior, Bureau of Land Management or by a decree of a Court of Law and/or that the corner points mentioned in lines 3, 4 and 5 above were in conformance with the rules of the Michigan Board of Land Surveyors or by a Decree of a Court of Law; established, re-established, monumented, re-monumented, recovered, found as expressed below:

NOTE: Not more than 4 corners, all in the same town and range, may be recorded on this certificate.

A. Description of original monument and accessories and/or subsequent restoration:

A-7 B-7 9

(NO EVIDENCE OF G.L.O. CORNER, B.T'S, LINE TREES & TOPOGRAPHY, AS CALLED OUT IN THE G.L.O. LINE NOTES; UNLESS NOTED IN ITEM "B" BELOW.)

STATE OF MICHIGAN
CARL KIISKILA
LAND SURVEYOR
No. 33981
LICENSED LAND SURVEYOR

B. Description of corner evidence found and/or method applied in restoring or reestablishing corner:

A-7
FOUND AND ACCEPTED 1/2" PIN IN CONC AS WITNESSED BY J. SCHWANDT P.S. FOR THE SW COR OF SEC 18. COR FITS WORK DONE BY J. SCHWANDT, P.S. #26466, IN THE AREA. THE MONUMENT IS LOCATED AT THE SW CORNER OF A FARM FIELD & NEAR SW EDGE OF GAS LINE OPENING THAT RUNS NW - SE.

B-7
FD OTSEGO CO. MON AS SET BY C. ROBINSON PS, IN 1982 AT FD 1/2" IRON ROD FOR S1/4 S-18. COR FITS CERT. OF SURVEY BY J. SCHWANDT (LIBER 337, PG 01); C. ROBINSON (JOB NO 93015 - REVISED SEPT 13, 1993) & BY L. CAVANAGH (LIBER 182, PG 68). COR IS IN CTR N-S B.TOP RD & IN LINE W/CTR DIRT RD EAST & IN LINE W/N. EDGE OF 2-TRACK TRAIL TO WEST.

9
FOUND AND ACCEPTED A 1" IRON PIPE FOR THE SW COR OF THE SE1/4 OF THE NE1/4 OF SEC 18.

16
ESTABLISHED THE SW COR OF THE SE1/4 OF THE SE1/4 OF SEC 18 PER STANDARD BLM PROCEDURE FOR THE SUBDIVISION OF A SECTION. CTR E-W WINDING TRAIL IS 6' S.

C. Description of monument for corner and accessories established to perpetuate locating the position of the corner:

A-7
FOUND CONC MON.

12" MAPLE CLUMP	N48°W	91.82'
10" MAPLE CLUMP	S86°W	61.66'
7" BLACK CHERRY	S17°W	51.77'
10" BLACK CHERRY	S59°E	81.72'

B-7
FOUND OTSEGO CO. MON.

*10" BEECH	S60°E	36.88'
P. POLE	S42°W	43.07'
*8" TRI MAPLE	N68°E	34.10'
10" W. PINE	N53°W	58.02'

*= OLD WIT BY C.ROBINSON L.S. #16390

9
FOUND 1" IRON PIPE AND SET CARSONITE POST.

6" OAK	S40°E	2.71'
6" BEECH	S30°W	18.82'
5" MAPLE	S88°W	16.28'
4" MAPLE	N14°W	13.68'

FALLS IN N-S B.WIRE FENCE.

16
SET 5/8" X 34" REROD. SET CARSONITE POST NORTH 33'.

14" OAK	S38°W	17.25'
6" TWIN R.MAPLE	S61°E	20.12'
6" R.MAPLE	N35°E	56.13'
9" TWIN R.MAPLE	N22°W	36.60'

Signed by Carl T. Kiiskila #33981 Date 2-26-97

Surveyor's Michigan License No. _____

FORM APPROVED BY MICHIGAN STATE BOARD OF LAND SURVEYORS, JAN. 28, 1971
REVISED MAY 14, 1975
REVISED JAN., 1983