LAND CORNER RECORDATION CERTIFICATE

Filing Requirement of Act 74, Mich. P.A. 1970

For corners in OTSEGO (County)

	Located In:	Corner Code ##
1. Public Land Survey	T 29N R 3W	D-6,D-7
	T ___ R ___	
	T ___ R ___	
	T ___ R ___	
2. Property Controlling	S 17 T ___ R ___	13
in Section	S ___ T ___ R ___	
3. Miscellaneous	S ___ T ___ R ___	
Property in Sec.	S ___ T ___ R ___	

Register of Deeds Stamp & File Number

4. Lot No. _____ , Recorded Plat _____
5. Private Claims _____

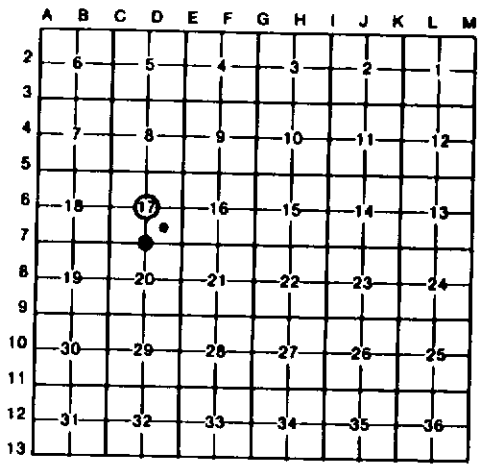

I, CARL KIISKILA, in a field survey on MAY 20, 19 96, do hereby certify that under requirements of P.A. 74, Michigan P.A. of 1970, the corner points mentioned in lines 1 and 2 above were in conformance with regulations and rules therefore as required in the current manual of survey instructions of the United States Department of the Interior, Bureau of Land Management or by a decree of a Court of Law and/or that the corner points mentioned in lines 3, 4 and 5 above were in conformance with the rules of the Michigan Board of Land Surveyors or by a Decree of a Court of Law; established, re-established, monumented, re-monumented, recovered, found as expressed below:

NOTE: Not more than 4 corners, all in the same town and range, may be recorded on this certificate.

A. Description of original monument and accessories and/or subsequent restoration:

D-6 13 D-7

(NO EVIDENCE OF G.L.O. CORNER, B.T'S, LINE TREES & TOPOGRAPHY, AS CALLED OUT IN THE G.L.O. LINE NOTES; UNLESS NOTED IN ITEM "B" BELOW.)

D-7CONT.)

STATE OF MICHIGAN
CARL KIISKILA
LAND SURVEYOR
No. 33981
LICENSED LAND SURVEYOR

B. Description of corner evidence found and/or method applied in restoring or reestablishing corner:

D-6
FOUND AND ACCEPTED A 1/2" BAR AS WITNESSED BY D. VERBA PS #13603 IN LIBER 1, PAGE 107 LCRC. THIS CORNER WAS ALSO ACCEPTED BY NUMEROUS OTHER SURVEYORS FOR SURVEYS IN THE AREA. THE CORNER IS 40'+/- EAST OF THE SE CORNER OF A PINE PLANTATION.

13
ESTABLISHED THE CTR OF THE SE1/4 OF SEC 17 PER STANDARD BLM PROCEDURE.

D-7
FOUND OTSEGO CO. MON FOR S1/4 COR OF SEC 17. IN 1953 CO. SURVEYOR S. THORSEN LS #5788 CALLED FOR A 1/2" X 48" BAR FOR THE S1/4 COR OF SEC 17; IN 1958 MSHD FOUND AND USED THE CONC MON FOR THE 1/4 COR; IN 1972 C. ROBINSON AND D. VERBA ALSO USED THE CONC MON FOR THE 1/4 COR; IN 1974 J. WILCOX FOUND 1/2" X 36" IRON ROD AND CONC MON - HE ACCEPTED THE

D-7CONT.)
MON FOR THE 1/4 COR BUT ALSO ACCEPTED S. THORSEN'S SUB. OF SE1/4 OF THE SW1/4 OF SEC 17; IN 1978 L. GERSCHBACHER FOUND 1/2" ROD & CONC MON AND ACCEPTED THE 1/2" ROD FOR THE 1/4 COR AND REPLACED IT WITH OTSEGO CO. MON (L.G.'S COR RECORD NOTED DELAMATER LIBER 2, PAGE 462 ALSO HAD ACCEPTED THE 1/2" ROD).

C. Description of monument for corner and accessories established to perpetuate locating the position of the corner:

D-6
DROVE A 1" X 36" PIPE W/CAP OVER A FD 1/2" BAR AND SET CARSONITE POST 1' NORTH.
14" RED PINE N52°W 47.86'
#30" W.PINE STMP N75°W 51.49'
#14" B.CHERRY S55°W 73.01'
5" WHITE PINE N85°E 103.97'

#= OLD WIT BY D. VERBA PS #13603.

13
SET 5/8" X 34" REROD W/CAP.
4" WHITE PINE N87°W 27.96'
3" WHITE PINE S09°W 36.51'
12" WHITE PINE S77°E 28.79'
2" WITCH HAZEL N08°E 1.85'
FD CONC MON (SET IN ERROR) 1' WEST OF ROW FN. S82°E 43.08'

D-7
FOUND OTSEGO CO. MON.
CONC MON S07°W 7.34'
UTILITY GUY POLE N24°E 28.02'
1/2" CAPPED IRON (#14102) N04°E 33.03'
#TAG & SHINER ON POWER POLE STUB S10°W 36.90'
GTE WARNING POST S68°W 60.53'
##NOTCH IN RR SIGN POST S57°E 45.91'

D-7CONT.)
CTR RR TRACKS EAST 62.8'
CTR E-W GRAVEL RD NORTH 2.0'

#= WIT BY D. SCHRIPSEMA PS #24617
##= WIT BY L. GERSCHBACHER PS #18990
#14102 = J. WILCOX

Signed by Carl T. Kiiskila Date 2-26-97

Surveyor's Michigan License No. #33981

FORM APPROVED BY MICHIGAN STATE BOARD OF LAND SURVEYORS, JAN. 28, 1971
REVISED MAY 14, 1975
REVISED JAN., 1983