LAND CORNER RECORDATION CERTIFICATE

Filing Requirement of Act 74, Mich. P.A. 1970

For corners in OTSEGO (County)

	Located In:	Corner Code ##
1. Public Land Survey	T 29N R 3W	D-5,E-6
	T ___ R ___	
	T ___ R ___	
	T ___ R ___	
2. Property Controlling	S 17 T ___ R ___	2,6
in Section	S ___ T ___ R ___	
3. Miscellaneous	S ___ T ___ R ___	
Property in Sec.	S ___ T ___ R ___	

Register of Deeds Stamp & File Number

4. Lot No. _____ , Recorded Plat _____
5. Private Claims _____

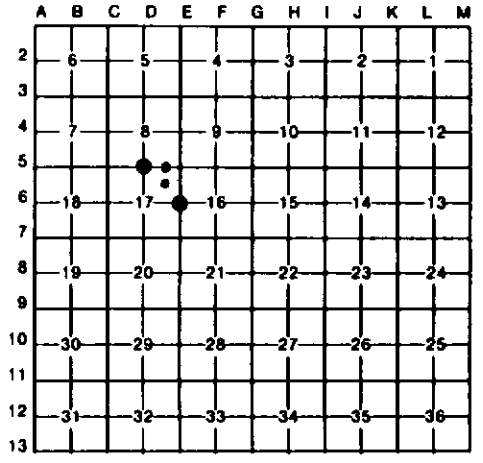

I, CARL KIISKILA , in a field survey on MAY 20 , 19 96 , do hereby certify that under requirements of P.A. 74, Michigan P.A. of 1970, the corner points mentioned in lines 1 and 2 above were in conformance with regulations and rules therefore as required in the current manual of survey instructions of the United States Department of the Interior, Bureau of Land Management or by a decree of a Court of Law and/or that the corner points mentioned in lines 3, 4 and 5 above were in conformance with the rules of the Michigan Board of Land Surveyors or by a Decree of a Court of Law; established, re-established, monumented, re-monumented, recovered, found as expressed below:

NOTE: Not more than 4 corners, all in the same town and range, may be recorded on this certificate.

A. Description of original monument and accessories and/or subsequent restoration:

D-5 E-6 2 6

(NO EVIDENCE OF G.L.O. CORNER, B.T'S, LINE TREES & TOPOGRAPHY, AS CALLED OUT IN THE G.L.O. LINE NOTES; UNLESS NOTED IN ITEM "B" BELOW.)

STATE OF MICHIGAN
CARL KIISKILA
LAND SURVEYOR
No. 33981
LICENSED LAND SURVEYOR

B. Description of corner evidence found and/or method applied in restoring or reestablishing corner:

D-5	E-6	2	6
FOUND 1-1/4" PIPE FOR N1/4 COR SEC 17, AS WITNESSED BY DON VERBA PS #13603 IN LIBER 1, PAGE 111. COR ALSO WITNESSED BY GERALD McKELVEY PS #19001 IN LIBER 1, PAGE 497.	FOUND AND ACCEPTED A 1/2" REROD AS WITNESSED BY DON VERBA PS #13603 FOR THE E1/4 COR OF SEC 17. THE CORNER FITS WORK DONE BY C.I. ROBINSON PS #16390 AND OTHERS IN THE AREA. POSSIBLE ORIG. BT 14" PINE STUMP WITH OLD AX MARKS N58°E 8.2'. GOVT NOTES CALL FOR A 12" W. PINE N50°E 13 LINKS (8.6').	FOUND RR SPIKE FOR THE NE COR OF THE NW1/4 OF THE NE1/4 OF SEC 17. SPIKE FITS A PROPORTIONATE POSITION PER GLO MEASUREMENTS - 1320' WEST (MEAS. 1323.43') TO 1/4 COR AND 1857.9' EAST (MEAS 1862.68') TO NE COR SEC 17.	ESTABLISHED THE CTR OF THE NE1/4 OF SEC 17 PER STANDARD BLM PROCEDURE.

C. Description of monument for corner and accessories established to perpetuate locating the position of the corner:

D-5

FOUND 1-1/4" IRON PIPE, RAISED WITH 3/4" IRON ROD.

#16" RED PINE	N70°E	92.24'
WELL CASING	S02°W	71.05'
##POWER POLE	S16°W	57.86'
##POWER POLE	N05°E	22.36'
CTR E-W B.TOP RD	SOUTH	24.8'
CTR N-S GRAVEL RD	EAST	30.7'

#= OLD WIT BY OTHERS

##= WIT BY D. VERBA PS #13603

E-6

FOUND 1/2" IRON ROD, REPLACED WITH OTSEGO CO. MON AND SET CARSONITE POST.

#16" OAK	S64°W	6.98'
#12" OAK	N34°E	10.31'
14" OAK	S05°W	27.66'
5" MAPLE	S77°E	38.20'
PINE STUMP W/OLD AX MARKS	N58°E	8.2'

#= WIT BY D. VERBA PS #13603

2

FOUND RR SPIKE IN CTR E-W B.TOP RD.

4" RED PINE	S59°W	42.89'
5" WHITE PINE	S29°E	36.28'
POWER POLE	N12°E	31.62'
7" RED PINE	N14°W	82.48'

6

SET 5/8"X34" REROD W/PS CAP.

8" R. MAPLE	N32°W	44.13'
14" TWIN OAK	N24°E	73.91'
5" R. MAPLE	S01°W	43.18'
16" TWIN OAK	S39°W	72.87'

Signed by Carl T. Kiiskila Date 2-26-97

Surveyor's Michigan License No. #33981

FORM APPROVED BY MICHIGAN STATE BOARD OF LAND SURVEYORS, JAN. 28, 1971
REVISED MAY 14, 1975
REVISED JAN., 1983