LAND CORNER RECORDATION CERTIFICATE

Filing Requirement of Act 74, Mich. P.A. 1970

For corners in OTSEGO (County)

	Located In:	Corner Code #/#
1. Public Land Survey	T 29N R 3W	E-7
	T ___ R ___	
	T ___ R ___	
	T ___ R ___	
2. Property Controlling	S 17 T ___ R ___	14,16
in Section	S ___ T ___ R ___	
3. Miscellaneous	S ___ T ___ R ___	
Property in Sec.	S ___ T ___ R ___	

Register of Deeds Stamp & File Number

4. Lot No. _____ , Recorded Plat _____
5. Private Claims _____

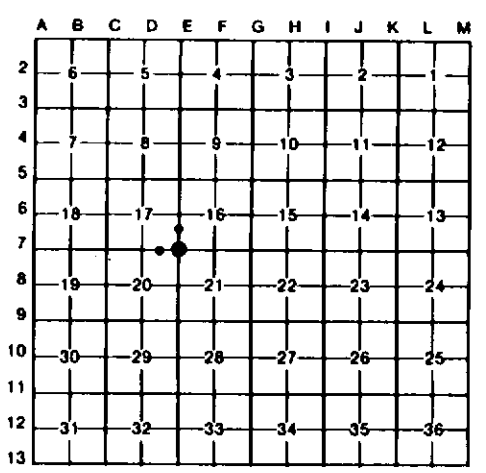

I, CARL KIISKILA, in a field survey on MAY 20, 19 96, do hereby certify that under requirements of P.A. 74, Michigan P.A. of 1970, the corner points mentioned in lines 1 and 2 above were in conformance with regulations and rules therefore as required in the current manual of survey instructions of the United States Department of the Interior, Bureau of Land Management or by a decree of a Court of Law and/or that the corner points mentioned in lines 3, 4 and 5 above were in conformance with the rules of the Michigan Board of Land Surveyors or by a Decree of a Court of Law; established, re-established, monumented, re-monumented, recovered, found as expressed below:

NOTE: Not more than 4 corners, all in the same town and range, may be recorded on this certificate.

A. Description of original monument and accessories and/or subsequent restoration:

E-7

14

16

(NO EVIDENCE OF G.L.O. CORNER, B.T'S, LINE TREES & TOPOGRAPHY, AS CALLED OUT IN THE G.L.O. LINE NOTES; UNLESS NOTED IN ITEM "B" BELOW.)

B. Description of corner evidence found and/or method applied in restoring or reestablishing corner:

E-7

FOUND AND ACCEPTED A BROKEN OFF OTSEGO CO. MON AS SET BY C.I.ROBINSON IN PLACE OF A CONC MON WITNESSED BY MDOT FOR THE SE COR OF SEC 17. THE COR FITS WORK DONE BY C.I.ROBINSON PS AND MDOT IN THE AREA.

14

ESTABLISHED THE SE COR OF THE NE1/4 OF THE SE1/4 OF SEC 17 PER STANDARD BLM PROCEDURE FOR THE SUBDIVISION OF A SECTION.

16

FOUND 1/2" REROD FOR SW COR OF THE SE1/4 OF THE SE1/4 OF SEC 17, COR FITS PROPER POSITION FOR STANDARD SUBDIVISION OF A SECTION PER BLM. CTR OF E-W 2-TRACK IS 13' SOUTH.

C. Description of monument for corner and accessories established to perpetuate locating the position of the corner:

E-7

FOUND BROKEN OTSEGO CO. MON. REPLACED W/NEW OTSEGO CO. MON AND SET CARSONITE POST.

6" OAK	N19°E	24.59'
14" RED PINE	N73°E	85.98'
##12" TRI MAPLE	S02°E	61.85'
#10" CHERRY CLMP	S61°E	44.16'
10" TRI MAPLE	S70°W	92.24'

##=WIT BY C.ROBINSON PS #16390
#= HWY WIT TAG

14

SET 5/8"X32" REROD W/CAP AND CARSONITE POST.

7" OAK	N50°W	10.62'
10" OAK	N52°E	16.74'
18" OAK	S44°E	12.72'
5" MAPLE	S11°W	31.11'

16

FOUND 1/2" REROD, SET 1" PIPE OVER W/PS CAP.

5" TRI MAPLE	N33°W	17.31'
3" WHITE PINE	N30°E	25.58'
3" WHITE PINE	N78°E	21.30'
9" BLACK CHERRY	S14°W	59.06'
FD 1/2" IRON BAR IN A 5" DIA POURED CONC MON	S12°W	3.43'

STATE OF MICHIGAN
CARL KIISKILA
LAND SURVEYOR
No. 33981
LICENSED LAND SURVEYOR

Signed by Carl T. Kiiskila Date 2-26-97

Surveyor's Michigan License No. #33981

FORM APPROVED BY MICHIGAN STATE BOARD OF LAND SURVEYORS, JAN. 28, 1971
REVISED MAY 14, 1975
REVISED JAN., 1983