

LAND CORNER RECORDATION CERTIFICATE

Filing Requirement of Act 74, Mich. P.A. 1970

For corners in Otsego (County)

Located In:

Corner Code #

OTSEGO COUNTY MICHIGAN RECEIVED FOR RECORD

95 NOV -3 PM 1:37

EVELYN M. PRATT CLERK / REGISTER OF DEEDS

Register of Deeds Stamp & File Number


1. Public Land Survey	T	29N	R	3W	G-3
	T		R		
	T		R		
	T		R		
2. Property Controlling in Section	S		T	R	
	S		T	R	
3. Miscellaneous Property in Section	S		T	R	
	S		T	R	

4. Lot No. _____, Recorded Plat _____

5. Private Claims _____

I, James L. Schwandt, in a field survey on October 22, 1995, do hereby certify that under requirements of P.A. 74, Michigan P.A. of 1970, the corner points mentioned in lines 1 and 2 above were in conformance with regulations and rules therefore as required in the current manual of survey instructions of the United States Department of the Interior, Bureau of Land Management or by a decree of a Court of Law and/or that the corner points mentioned in lines 3, 4 and 5 above were in conformance with the rules of the Michigan Board of Professional Surveyors or by a Decree of a Court of Law; established, re-established, monumented, re-monumented, recovered, found as expressed below:

NOTE: Not more than 4 corners, all in the same town and range, may be recorded on this certificate.

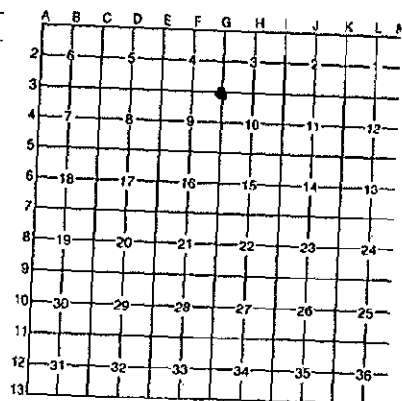

A. Description of original monument and accessories and/or subsequent restoration:

G-3 T29N-R3W

G.L.O. Harvey Mellen, 1857 Set Post at corner of Sections 3, 4, 9 and 10 9" Beech N25°E 33' 10" Beech S46°W 25'

Delamater, March 1922 Established by measurement Shows gas pipe set 36" W.P.S. N25°E 79 links 36" W.P.S. S64°E 36 1/2' 6" B. Cherry N72°W 74 1/2'

Carl J. Robinson, August 1972 Fd. steel fence post - No mention Delamater wit., LCRC, L 1, P 89 6" Oak (Spk. in E. side) S5°W 4.1' 4" Maple (Spk. in E. side) N10°E 23.15' 6" Poplar (Spk. in SW side) N40°W 26.82'

Carl Robinson, 1989 1" iron pipe 18" Aspen N45°E 26.79'; 12" Aspen S35°E 29.64'; 12" Maple S68°W 31.38'; 6" Maple N57°W 24.28'

B. Description of corner evidence found and/or method applied in restoring or reestablishing corner:

Corner destroyed by gas line installation Reset Corner from witnesses (Otsego County Mon. set)

1. Fd. Spk. in 18" Aspen N45°E 26.79'
2. Fd. Spk. in 12" Aspen S35°E 29.64'
3. Fd. Spk. in 12" Maple S68°W 31.38'

C. Description of monument for corner and accessories established to perpetuate locating the position of the corner:

G-3 Otsego County Mon. set.


1. Fd. Spk. in 18" Aspen N45°E 26.79'
2. Fd. Spk. in 12" Aspen S35°E 29.64'
3. Fd. Spk. in 12" Maple S68°W 31.38'
4. Set Spk. in 6" Maple S8°W 11.75'

And is a careful and faithful reestablishment of the position of the original corner.

OTSEGO COUNTY REMONUMENTATION

Approved by the County Survey Peer Group, pursuant to Act 345, PA 1990.

Nov. 2, 1995 Date Chairman

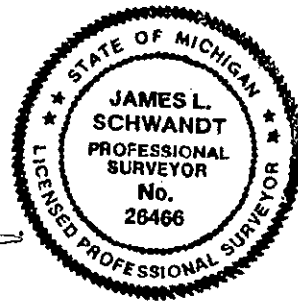

Signed by James L. Schwandt, PS Surveyor's Michigan License No. 26466

Date 11-2-95