

LAND CORNER RECORDATION CERTIFICATE

Filing Requirement of Act 74, Mich. P.A. 1970
ALSO ACT 345, PA 1990


For corners in

OTSEGO (County)	Located In:	Corner Code #
1. Public Land Survey	T 29N R 3W	H-4
	T _____ R _____	_____
	T _____ R _____	_____
	T _____ R _____	_____
2. Property Controlling in Section	S _____ T _____ R _____	_____
	S _____ T _____ R _____	_____
3. Miscellaneous Property in Sec.	S _____ T _____ R _____	_____
	S _____ T _____ R _____	_____

OTSEGO COUNTY
MICHIGAN
RECEIVED FOR RECORD
95 NOV -2 AM 10:11
LYELYN M. PRATT
CLERK / REGISTER OF DEEDS

Register of Deeds Stamp & File Number

4. Lot No. _____, Recorded Plat _____
5. Private Claims _____

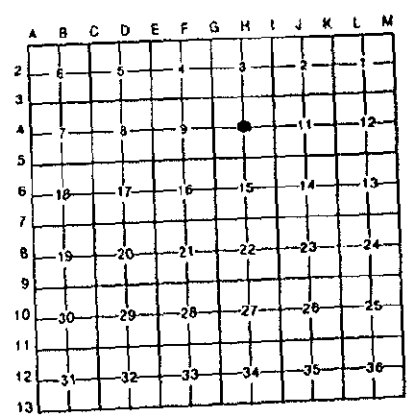

I, JAMES L. SCHWANDT, in a field survey on NOVEMBER 23, 19 94, do hereby certify that under requirements of P.A. 74, Michigan P.A. of 1970, the corner points mentioned in lines 1 and 2 above were in conformance with regulations and rules therefor as required in the current manual of survey instructions of the United States Department of the Interior, Bureau of Land Management or by a decree of a Court of Law and/or that the corner points mentioned in lines 3, 4 and 5 above were in conformance with the rules of the Michigan Board of Land Surveyors or by a Decree of a Court of Law; established, re-established, monumented, re-monumented, recovered, found as expressed below:

NOTE: Not more than 4 corners, all in the same town and range, may be recorded on this certificate.

A. Description of original monument and accessories and/or subsequent restoration:

No G.L.O. or Delamater	O.C.M. set by
C. Eugene Ostling #12026	Carl I. Robinson #16390
Set 1/2" iron	January 12, 1989
(1) 8" Maple S13°E 16.5'	LCRC L. 3, Pg 23
(2) 6" Maple S63°30'W 12.20'	3" Maple N50°E 3.68'
	6" Maple S05°E 21.33'
	6" Maple S39°W 15.03'
	5" Maple N32°W 8.40'

DEC 10 1991
COMMISSION


B. Description of corner evidence found and/or method applied in restoring or reestablishing corner:

Found O.C.M. set by Carl Robinson fitting all witnesses listed on C.I. Robinson's survey dated 12-22-88. C. Ostling set cor midway of the North and South 1/4 line which is, as C. I. Robinson states in his LCRC (L3, Pg 23), an erroneous procedure. Robinson set new corner at the intersection of the North and South 1/4 line with the East and West 1/4 line, which is 4.7' North of the Ostling Cor.

C. Description of monument for corner and accessories established to perpetuate locating the position of the corner:

H-4 This position not established by original government surveyors. This monument is accepted as the best available evidence of the position of the corner.

3" Maple N54°E 3.68' Found Nail
6" Maple S05°E 21.33' Found Nail
6" Maple S50°W 15.03' Found Nail
5" Maple N34°W 8.40' Found Nail
Centerline Amoco Road East 43'

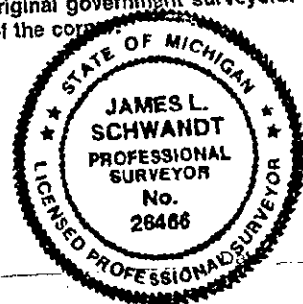

OTSEGO COUNTY REMONUMENTATION
Approved by the County Survey Peer Group, pursuant to Act 345, PA 1990.
Date Aug 3, 1995
Chairman [Signature]

Signed by James L. Schwandt
Surveyor's Michigan License No. 26466

AUGUST 3, 1995