

# REMONUMENTATION

APR 25 1995

## COMMISSION

For corners in

OTSEGO COUNTY REMONUMENTATION

### LAND CORNER RECORDATION CERTIFICATE

Filing Requirement of Act 74, Mich. P.A. 1970

ALSO ACT 345, PA 1990

LIBER 0004 PAGE 029

OTSEGO (County)	Located In:	Corner Code #
1. Public Land Survey	T <u>29N</u> R <u>3W</u>	<u>I-5</u>
	T _____ R _____	_____
	T _____ R _____	_____
	T _____ R _____	_____
2. Property Controlling in Section	S _____ T _____ R _____	_____
	S _____ T _____ R _____	_____
3. Miscellaneous Property in Sec.	S _____ T _____ R _____	_____
	S _____ T _____ R _____	_____

OTSEGO COUNTY  
MICHIGAN  
RECEIVED FOR RECORD  
94 DEC 14 PM 4:04  
EVELYN M. PRATT  
CLERK / REGISTER OF DEEDS

Register of Deeds Stamp & File Number

4. Lot No. \_\_\_\_\_, Recorded Plat \_\_\_\_\_  
5. Private Claims \_\_\_\_\_

I, James L. Schwandt, in a field survey on November 14, 19 94, do hereby certify that under requirements of P.A. 74, Michigan P.A. of 1970, the corner points mentioned in lines 1 and 2 above were in conformance with regulations and rules therefore as required in the current manual of survey instructions of the United States Department of the Interior, Bureau of Land Management or by a decree of a Court of Law and/or that the corner points mentioned in lines 3, 4 and 5 above were in conformance with the rules of the Michigan Board of Land Surveyors or by a Decree of a Court of Law; established, re-established, monumented, re-monumented, recovered, found as expressed below:

**NOTE: Not more than 4 corners, all in the same town and range, may be recorded on this certificate.**

	A	B	C	D	E	F	G	H	I	J	K	L
2	6	5	4	3	2	1						
3												
4	7	8	9	10	11	12						
5					15	14						
6	18	17	16	15	14	13						
7												
8	19	20	21	22	23	24						
9												
10	30	29	28	27	26	25						
11												
12	31	32	33	34	35	36						
13												

A. Description of original monument and accessories and/or subsequent restoration:

G.L.O. Harvey Mellen, 1857  
Set Post  
24" Hemlock S42°W 18 Lks.  
9" W. Pine N83°E 27 Lks.

Carl I. Robinson #16390  
1981, Set O.C.M.

Fd. 1/2" bar 1.0' S. of centerline E-W Road  
Fd. Delamater's tag in 36" W.P.S. N24°E 78.1'; Fd. Nail in G.W. tag in 8" Aspen N45°W 62.78'  
Set Spk. 12" Tw. Maple N58°E 80.45'; Set Spk. 6" Multi. Maple N30°W 69.85';  
Set Spk. 8" Multi. Maple S05°W 119.90'; Fd. 36" W.P.S. N24°E 78.10'

Delamater  
Fd. what appeared to be  
roots of both B's & old post  
Set 1/2" x 30" bar in corner  
36" W.P.S. N24°E 78.1'  
16" W.P.S. S71°W 46.1'

C. Eugene Ostling #12026  
September 25, 1972  
Set 1/2" bar  
12" Tw. Maple N67°E 81.0'  
8" Poplar N55°15'W 62.5'  
6" Maple S23°15'W 92.6'


B. Description of corner evidence found and/or method applied in restoring or reestablishing corner:

Found O.C.M. set by C.I. Robinson 5-13-94 per L.C.R.C. same date and referenced to C.S.R., Liber 4, Page 96; G.F. Delamater 1931. Position of O.C.M. fits all of Robinson's witnesses; Ostling's, Maple and Poplar; and Delamater's 36" W.P.S. Delamater's position was based on what appeared to be recovered G.L.O. evidence.

C. Description of monument for corner and accessories established to perpetuate locating the position of the corner:

I-5 Found O.C.M. is accepted as a careful and faithful perpetuation of the position of the original corner.

36" W.P.S. N24°E 78.1' Found Nail  
12" Twin Maple N73°E 80.45' Found Nail  
Multi-Maple S05°W 119.90' Found Spike  
8" Aspen N45°W 62.70' Found G-W Tag

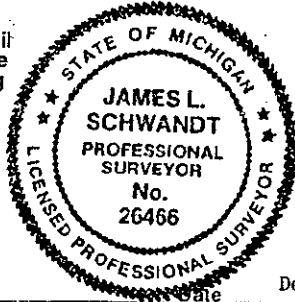

OTSEGO COUNTY REMONUMENTATION

Approved by the County Survey Peer  
Group, pursuant to Act 345, PA 1990.

Dec. 13, 1994  
Date

*[Signature]*  
Chairman

Signed by James L. Schwandt  
James L. Schwandt, PS  
Surveyor's Michigan License No. 26466

December 7, 1994