

OTSEGO COUNTY REMONUMENTATION
LAND CORNER RECORDATION CERTIFICATE
 Filing Requirement of Act 74, Mich. PA 1970

For Corners In:
Otsego Located In Otsego Lk. Twp. Corner Code #
 (County)

1. Public Land Survey	S 25	T <u>29N</u>	R <u>3W</u>	<u>A-9</u>
		T _____	R _____	_____
2. Property Controlling in Section	S _____	T _____	R _____	_____
	S _____	T _____	R _____	_____
3. Miscellaneous Property in Section	S _____	T _____	R _____	_____
	S _____	T _____	R _____	_____

4. Lot No: _____ Recorded Plat: _____

5. Private Claims: _____

I, Carl T. Kiiskila, in a field survey on September 30, 2002 do hereby state that under requirements of PA 74, Michigan PA of 1970, the corner points mentioned in lines 1 and 2 above were in conformance with regulations and rules therefore as required in the current manual of survey instructions of the United States Department of the Interior, Bureau of Land Management or by a decree of a Court of Law and/or that the corner points mentioned in lines 3, 4 and 5 above were in conformance with the rules of the Michigan Board of Land Surveyors or by a Decree of a Court of Law; established, re-established, monumented, recovered, found as expressed below:

NOTE: Not more than 2 corners, all in the same town and range, may be recorded on this certificate.

A. Description of original monument and accessories and/or subsequent restoration:

A-9 G.L.O. 1839 James H. Mullett
 Set post corner sections 24 and 25
 Wit: Beech 10 S35°W 25 links
 Beech 12 N56°W 25 links

B. Description of corner evidence found and/or method applies in restoring or re-establishing corner:

A-9 Re-established the Northeast corner of section 25 by single proportionate measurement between corners A-8 and A-10.


C. Description of monument for corner and accessories established to perpetuate locating the position of the corner:

A-9 Set Otsego County Monument as a careful and faithful re-establishment of the position of the original corner.

Wit: 18" Oak	N62°W	28.32'
26" Oak	N20°W	23.98'
8" Maple	N48°E	14.95'
6" Beech	South	20.85'
Carsonite Post	North	1'±

Register of Deeds Stamp & File Number

A	B	C	D	E	F	G	H	I	J	K	L	M
1												
2	6		5		4		3		2		1	
3												
4	7		8		9		10		11		12	
5												
6	18		17		16		15		14		13	
7												
8	19		20		21		22		23		24	
9												
10	30		29		28		27		26		25	
11												
12	31		32		33		34		35		36	
13												

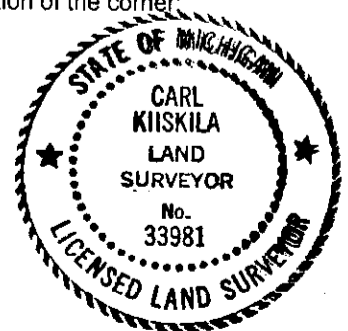

Signed by:

Carl T. Kiiskila

Date:

12-23-02

Surveyor's Michigan License No.:

33981