


MAP SHEET


TOWN 29 N RANGE 4 W

DATE	FILE NO.
DIVISION	DISTRICT
MAPPED BY:	
PROTO NUMBERS	

COUNTY	TOWNSHIP	NUMBER OF ACRES
<u>Ossego</u>		
OWNER OF LAND		
PURPOSE OF MAP		

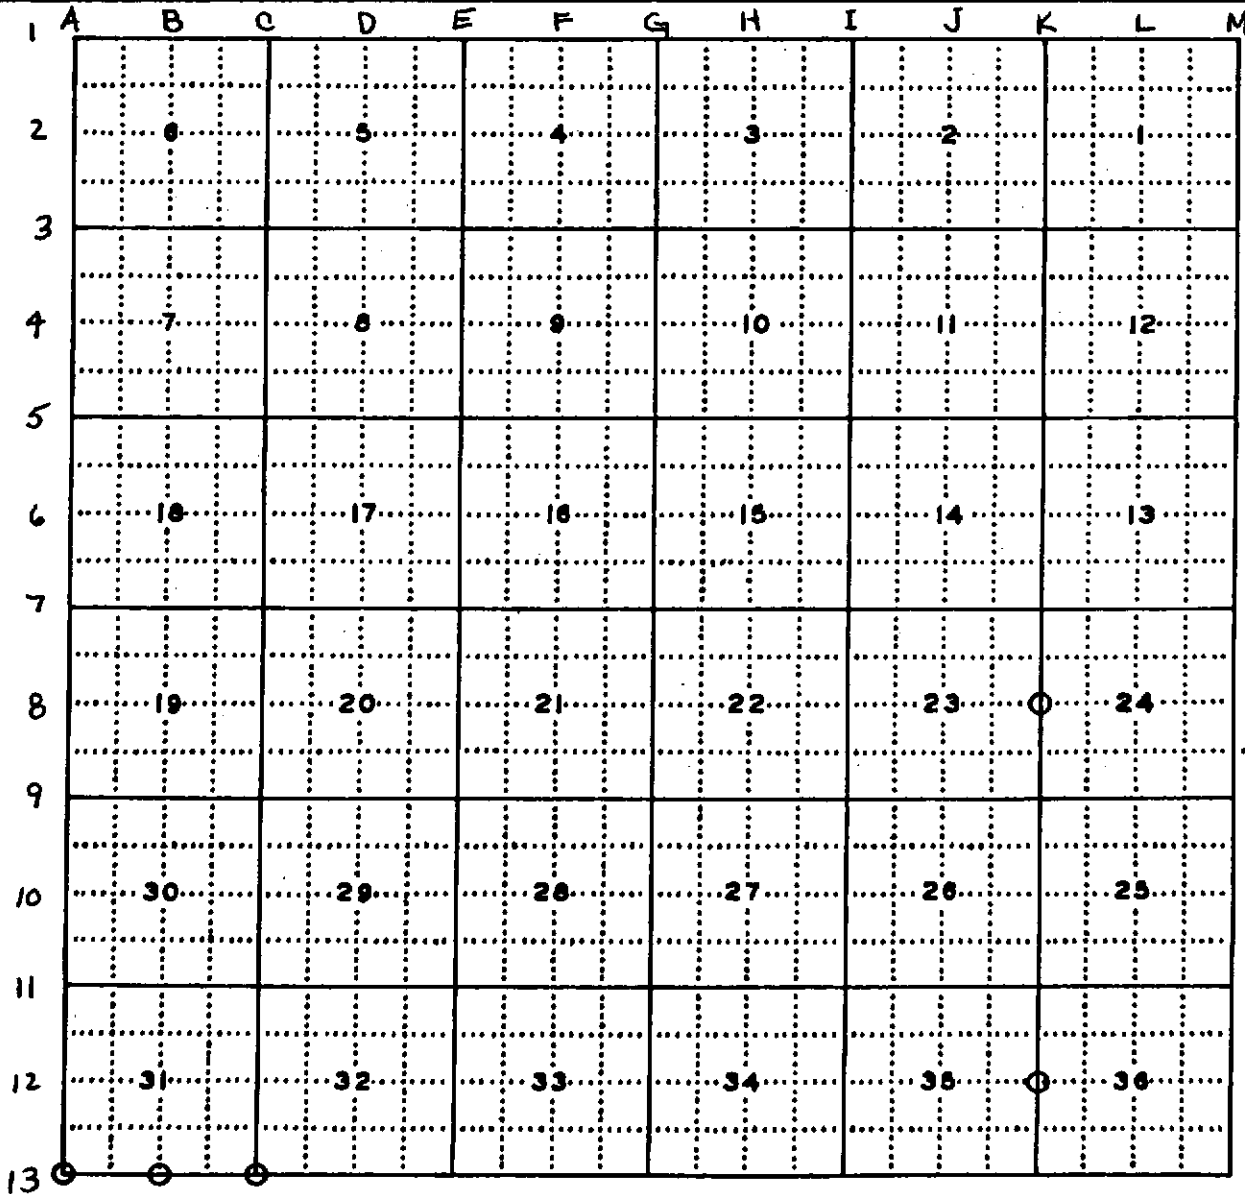

REMARKS

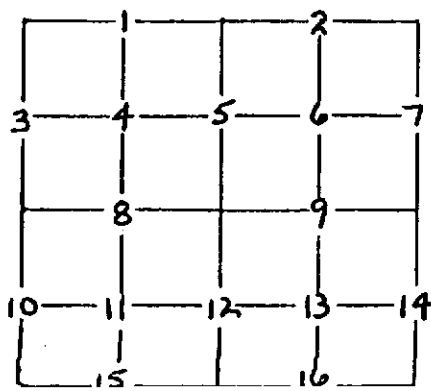

- denotes 2 records