LAND CORNER RECORDATION CERTIFICATE

Filing Requirement of Act 74, Mich. P.A. 1970

For corners in
OTSEGO
(County)

	Located In:	Corner Code ##
1. Public Land Survey	T 29N R 4W	D-13
	T ___ R ___	E-13
	T ___ R ___	
	T ___ R ___	
2. Property Controlling	S 32 T ___ R ___	15
in Section	S 32 T ___ R ___	16
3. Miscellaneous	S ___ T ___ R ___	
Property in Sec.	S ___ T ___ R ___	

Register of Deeds Stamp & File Number

4. Lot No. ___, Recorded Plat ___
5. Private Claims ___

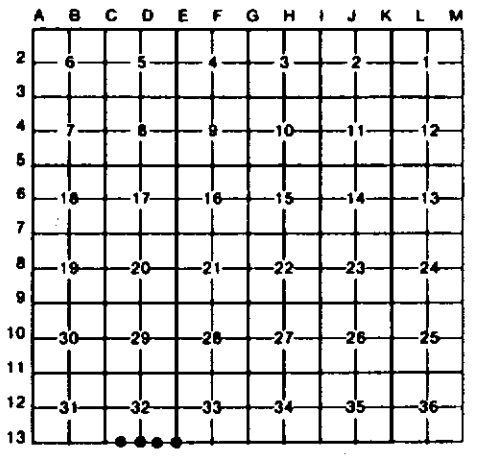

I, Carl R. Johnson, in a field survey on March 31, 19 92, do hereby certify that under requirements of P.A. 74, Michigan P.A. of 1970, the corner points mentioned in lines 1 and 2 above were in conformance with regulations and rules therefore as required in the current manual of survey instructions of the United States Department of the Interior, Bureau of Land Management or by a decree of a Court of Law and/or that the corner points mentioned in lines 3, 4 and 5 above were in conformance with the rules of the Michigan Board of Land Surveyors or by a Decree of a Court of Law; established, re-established, monumented, re-monumented, recovered, found as expressed below:

NOTE: Not more than 4 corners, all in the same town and range, may be recorded on this certificate.

STATE OF MICHIGAN
CARL R. JOHNSON
LAND SURVEYOR
No. 30083
LICENSED LAND SURVEYOR

A. Description of original monument and accessories and/or subsequent restoration:

D-13	E-13	15	16

B. Description of corner evidence found and/or method applied in restoring or reestablishing corner:

D-13	E-13	15	16
Set midway and on line between found section corners. No evidence of original or subsequent survey.	Found monument in place as established in a previous survey	Set by standard survey procedure for subdivision of a section.	Found monument in place, set by standard survey procedure for subdivision of a section.

C. Description of monument for corner and accessories established to perpetuate locating the position of the corner:

D-13	E-13	15	16
S 1/4 cor. sec. 32	SE Cor. sec. 32	N1/8 cor. on S. line sec. 32	E1/8 cor on S. line sec. 32
Set DNR Mon.	Found DNR Mon.	Set 5/8" Bar w/cap	Found 1/2" Iron Pipe w/cap
Approximately 5 feet north of	Power Pole N08W 19.4 ft	N. Pine Stp 40" S88W 64.80 ft	Cherry 10" N52E 26.60 ft
e-w trail road.	Maple 3" S81E 36.38 ft	Triple Maple N35E 71.42 ft	Cherry 10" N76W 78.90 ft
No other witnesses available.	Maple 6" S11E 34.68 ft	Cherry 4" S24E 61.95 ft	Ironwood 8" S22W 51.15 ft
	Aspen 4" S80W 11.13 ft		Sq. Fence Post N15W 7.6 ft

Signed by Carl R. Johnson Date 7/7/92

Surveyor's Michigan License No. 30083

FORM APPROVED BY MICHIGAN STATE BOARD OF LAND SURVEYORS, JAN. 28, 1971
REVISED MAY 14, 1975
REVISED JAN., 1983